

marked up 7-6-14



Property of TK Constructors, Inc.

PAGE NO. 10

ADDENDUM 1

VER. 112210

DRAWING BY: SES

1/8" = 1'

DATE: April 02, 2014

JOB NO.: 210-14-0429

TK CONSTRUCTORS


AUGUSTA

Handwritten signature and date: *AS* 4/2/14

FIRST FLOOR PLAN

ANDERSEN WINDOW SCHEDULE - 200 SERIES -	
ANDERSEN MODEL NO.	R.O. SIZE
3030	36" x 36"
3040	36" x 48"
3049*	36" x 57"
3056*	36" x 66"
3060*	36" x 72"
3049 MULL*	73" x 57"
3056 MULL*	73" x 66"
3060 MULL*	73" x 72"
ANDERSEN SLIDING DOOR R.O. 72 3/4" x 82 7/8"	
3'-0" FRONT DOOR R.O. 38 3/8" x 82 1/2"	
3'-0" FRONT DOOR WITH (1) SIDELITE R.O. 51 1/8" x 82 1/2"	
3'-0" FRONT DOOR WITH (2) SIDELITES R.O. 65 3/8" x 82 1/2"	
R.O. FOR BI-FOLD DOORS USING DRYWALL JAMB FACING + 1 1/4" + DOOR SIZE x (81 1/2")	
R.O. FOR BYPASS DOORS USING DRYWALL JAMB FACING MAKE SAME AS BOTH DOORS ADDED TOGETHER	
ALL INTERIOR DOORS SIZE + 2" TO WIDTH x 82 1/2" HIGH	
R.O. POCKET DOOR (2X DOOR WIDTH + 7") x 85" HIGH	

\* - DENOTES OPENING MEETS EGRESS REQUIREMENTS

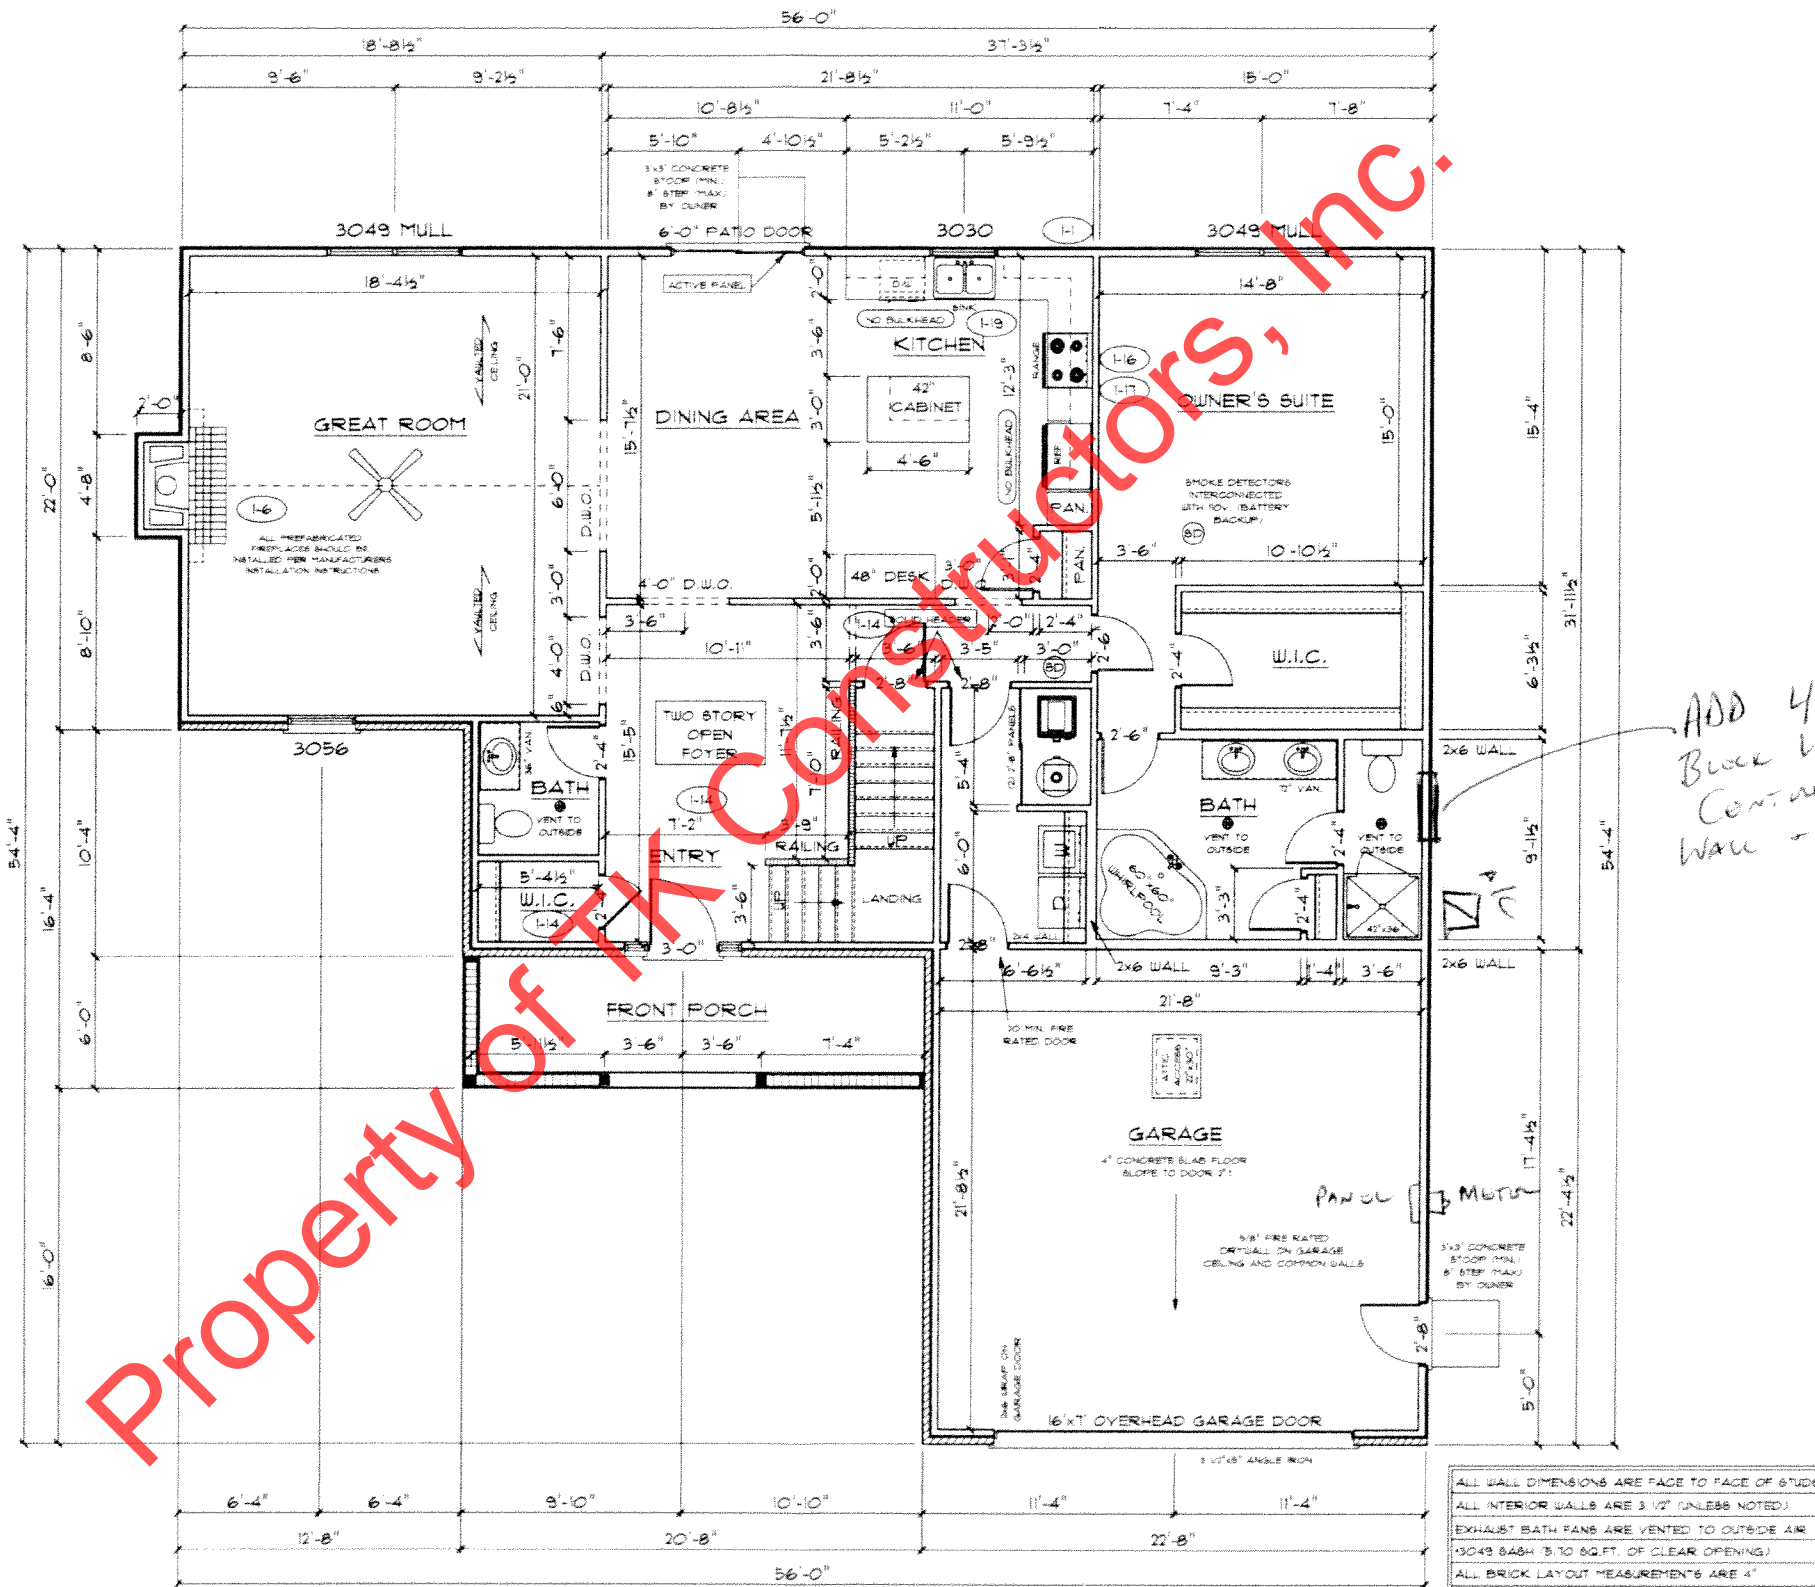

ALL WALL DIMENSIONS ARE FACE TO FACE OF STUDS  
 ALL INTERIOR WALLS ARE 3/2" (UNLESS NOTED)  
 EXHAUST BATH FANS ARE VENTED TO OUTSIDE AIR  
 (3049 BASH 3 TO 60 FT. OF CLEAR OPENING)  
 ALL BRICK LAYOUT MEASUREMENTS ARE 4"

ADD 40x40 GALL  
 BLOCK WINDOW -  
 CENTERED BETWEEN  
 WALL - SHOWN


*B. Anna*

FIRST FLOOR SQ. FT.	1680
SECOND FLOOR SQ. FT.	985
TOTAL LIVING SQ. FT.	2665
GARAGE	499
TOTAL SQ. FT.	3164
EXCLUDING PORCH	124

SECOND FLOOR PLAN

ANDERSEN WINDOW SCHEDULE - 200 SERIES -	ANDERSEN MODEL NO.	R.O. SIZE
3030	36" x 36"	3030
3040	36" x 48"	3040
3049	36" x 57"	3049
3056	36" x 66"	3056
3060	36" x 72"	3060
3049 MULL.	73" x 57"	3049
3056 MULL.	73" x 66"	3056
3060 MULL.	73" x 72"	3060
ANDERSEN SLIDING DOOR		
R.O. 72 3/4" x 82 1/8"		
3'-0" FRONT DOOR		
R.O. 36 3/8" x 82 1/2"		
3'-0" FRONT DOOR WITH (1) SIDELITE		
R.O. 51 7/8" x 82 1/2"		
3'-0" FRONT DOOR WITH (2) SIDELITES		
R.O. 65 3/8" x 82 1/2"		
R.O. FOR BIFOLD DOORS USING DRYWALL JAMB FACING + 1 1/4" + DOOR SIZE x (81 1/2")		
R.O. FOR BYPASS DOORS USING DRYWALL JAMB FACING MAKE SAME AS BOTH DOORS ADDED TOGETHER		
ALL INTERIOR DOORS		
SIZE + 2" TO WIDTH x 82 1/2" HIGH		
R.O. POCKET DOOR		
(2) DOOR WIDTH + (1") x 85" HIGH		

• - DENOTES OPENING MEETS EGRESS REQUIREMENTS

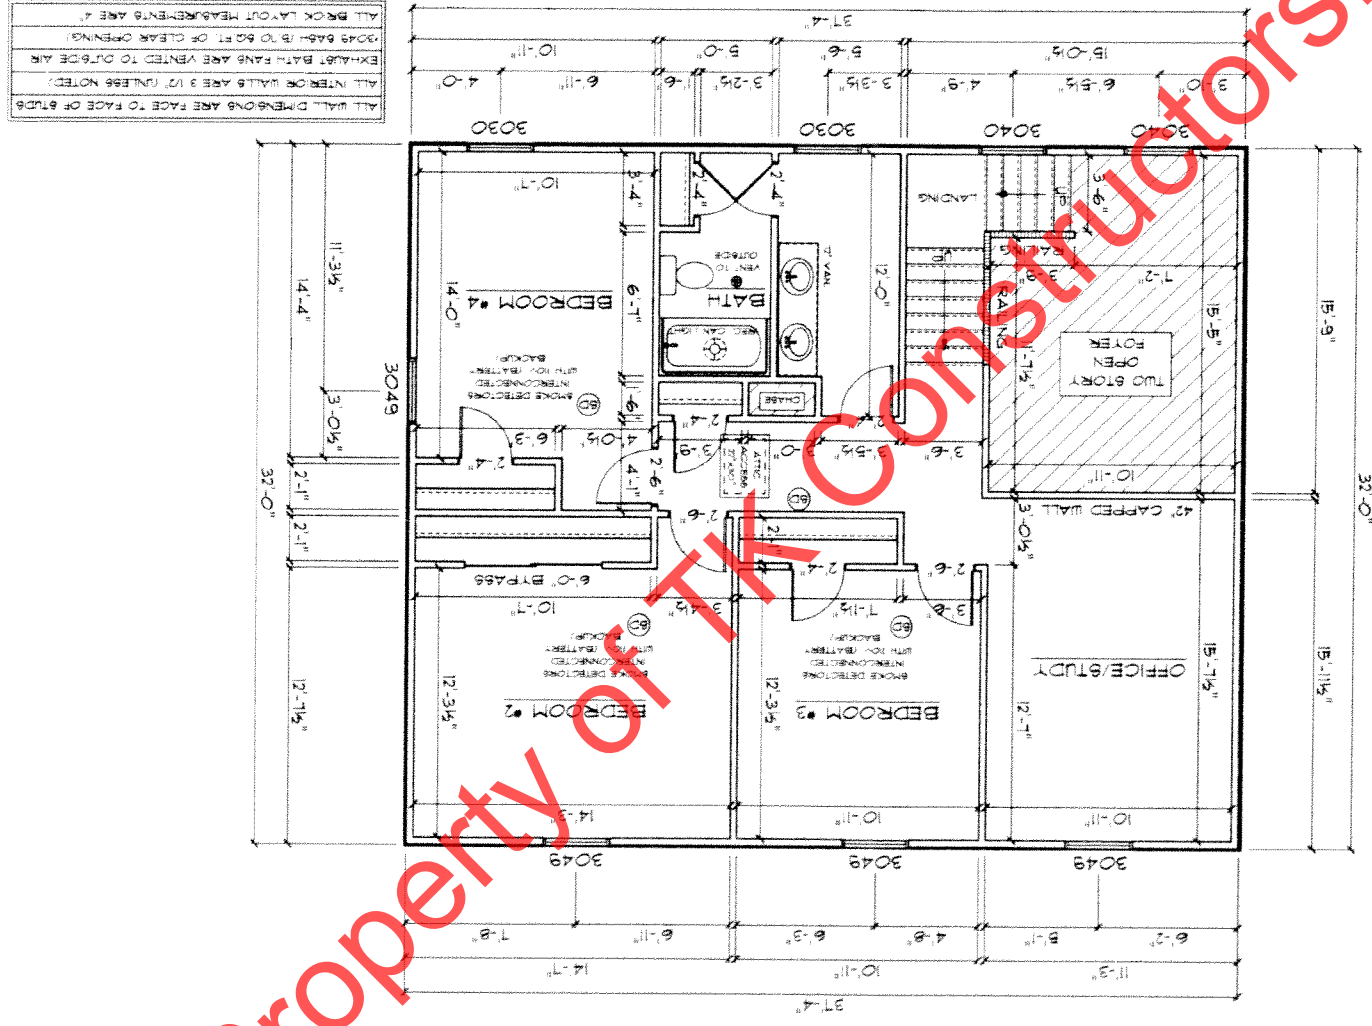

ALL WALL DIMENSIONS ARE FACE TO FACE OF STUDS  
 ALL INTERIOR WALLS ARE 3 1/2" UNLESS NOTED  
 EXHAUST BATH FANS ARE VENTED TO OUTSIDE AIR  
 3049 BATH (B) TO 66 FT. OF CLEAR OPENING  
 ALL BRICK LAYOUT MEASUREMENTS ARE 4"

Handwritten notes: "King" and a signature.

**TK CONSTRUCTORS**  
**AUGUSTA**

DATE: April 02, 2014  
 JOB NO.: 210-14-0429



APPENDUM 1  
 VER: 11210  
 DRAWING BY: SES  
 1/8" = 1'