



FRONT ELEVATION


Property of TK Constructors, Inc.

MK

TK CONSTRUCTORS
BIRMINGHAM

DATE: November 14, 2013

JOB NO.: 212-14-0116

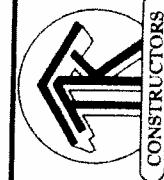

ADDENDUM 1

VER:

DRAWING BY: RLC

1/8" = 1'

PAGE NO.:

1B

1-10 1-11 1-21 1-42
FIRST FLOOR PLAN

**ANDERSEN WINDOW SCHEDULE
 - 200 SERIES -**

ANDERSEN MODEL NO.	R.O. SIZE
3030	36" x 36"
3040	36" x 48"
3049*	36" x 57"
3056*	36" x 66"
3060*	36" x 72"
3049 MULL*	73" x 57"
3056 MULL*	73" x 66"
3060 MULL*	73" x 72"

ANDERSEN SLIDING DOOR	R.O.
12 3/4" x 82 1/8"	12 3/4" x 82 1/8"
3'-0" FRONT DOOR	38 3/8" x 82 1/2"
3'-0" FRONT DOOR WITH (1) SIDELITE	51 1/8" x 82 1/2"
3'-0" FRONT DOOR WITH (2) SIDELITES	65 3/8" x 82 1/2"


R.O. FOR BI-FOLD DOORS USING DRYWALL
 JAMB FACING + 1 1/4" + DOOR SIZE x (81 1/2")

R.O. FOR BYPASS DOORS USING DRYWALL
 JAMB FACING MAKE SAME AS BOTH DOORS
 ADDED TOGETHER

ALL INTERIOR DOORS
 SIZE + 2" TO WIDTH x 82 1/2" HIGH

R.O. POCKET DOOR
 (2x DOOR WIDTH + 1") x 85" HIGH

* - DENOTES OPENING MEETS
 EGRESS REQUIREMENTS

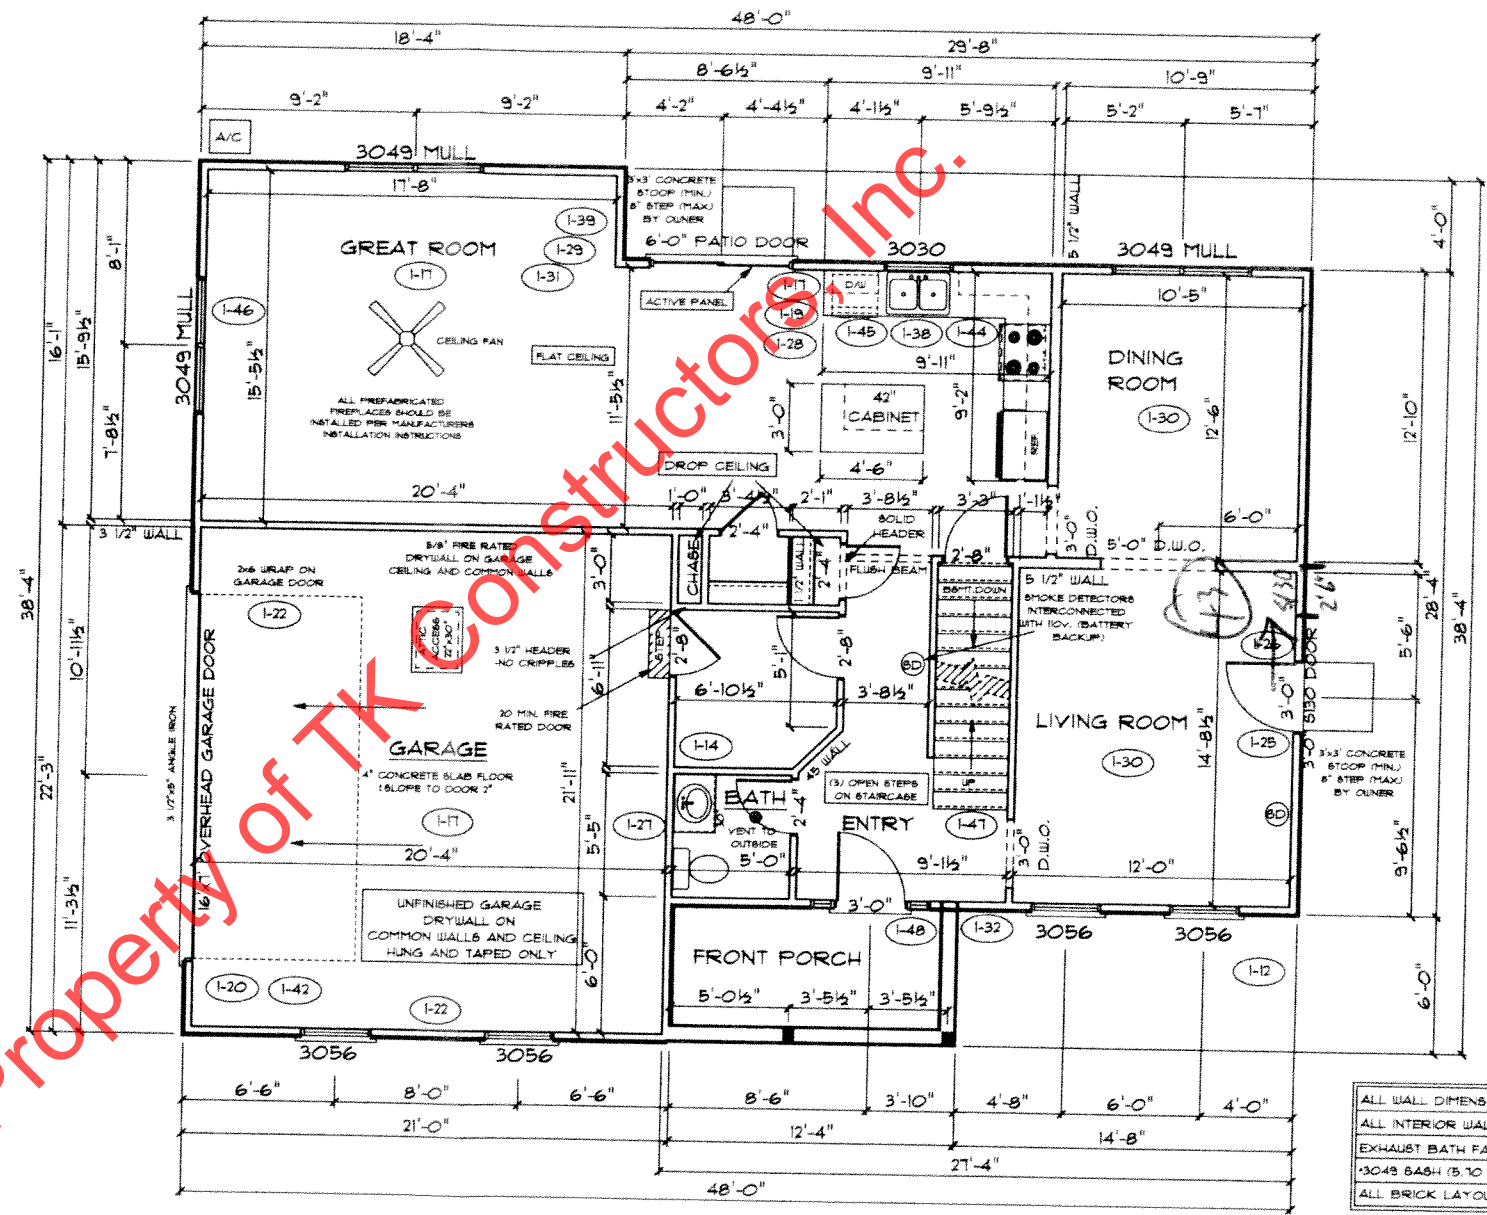

ALL WALL DIMENSIONS ARE FACE TO FACE OF STUDS
 ALL INTERIOR WALLS ARE 3 1/2" (UNLESS NOTED)
 EXHAUST BATH FANS ARE VENTED TO OUTSIDE AIR
 3049 BASH (5 TO 80 FT. OF CLEAR OPENING)
 ALL BRICK LAYOUT MEASUREMENTS ARE 4"



Handwritten initials



SECOND FLOOR PLAN

First Floor Sq.ft.	1091
Second Floor Sq.ft.	1114
Total Living Sq.ft.	1811
Garage	464
Total Sq.ft.	2335
Excluding Porch	14

**ANDERSEN WINDOW SCHEDULE
- 200 SERIES -**

ANDERSEN MODEL NO.	R.O. SIZE
3030	36" x 36"
3040	36" x 48"
3049*	36" x 51"
3056*	36" x 66"
3060*	36" x 72"
3049 MULL*	73" x 51"
3056 MULL*	73" x 66"
3060 MULL*	73" x 72"
ANDERSEN SLIDING DOOR R.O. 72 3/4" x 82 7/8"	
3'-0" FRONT DOOR R.O. 36 3/8" x 82 1/2"	
3'-0" FRONT DOOR WITH (1) SIDELITE R.O. 51 1/8" x 82 1/2"	
3'-0" FRONT DOOR WITH (2) SIDELITES R.O. 65 3/8" x 82 1/2"	
R.O. FOR BIFOLD DOORS USING DRYWALL JAMB FACING = 1 1/4" + DOOR SIZE x (81 1/2")	
R.O. FOR BYPASS DOORS USING DRYWALL JAMB FACING MAKE SAME AS BOTH DOORS ADDED TOGETHER	
ALL INTERIOR DOORS SIZE + 2" TO WIDTH x 82 1/2" HIGH	
R.O. POCKET DOOR (2x DOOR WIDTH + 1") x 82" HIGH	

* - DENOTES OPENING MEETS
EGRESS REQUIREMENTS

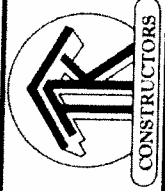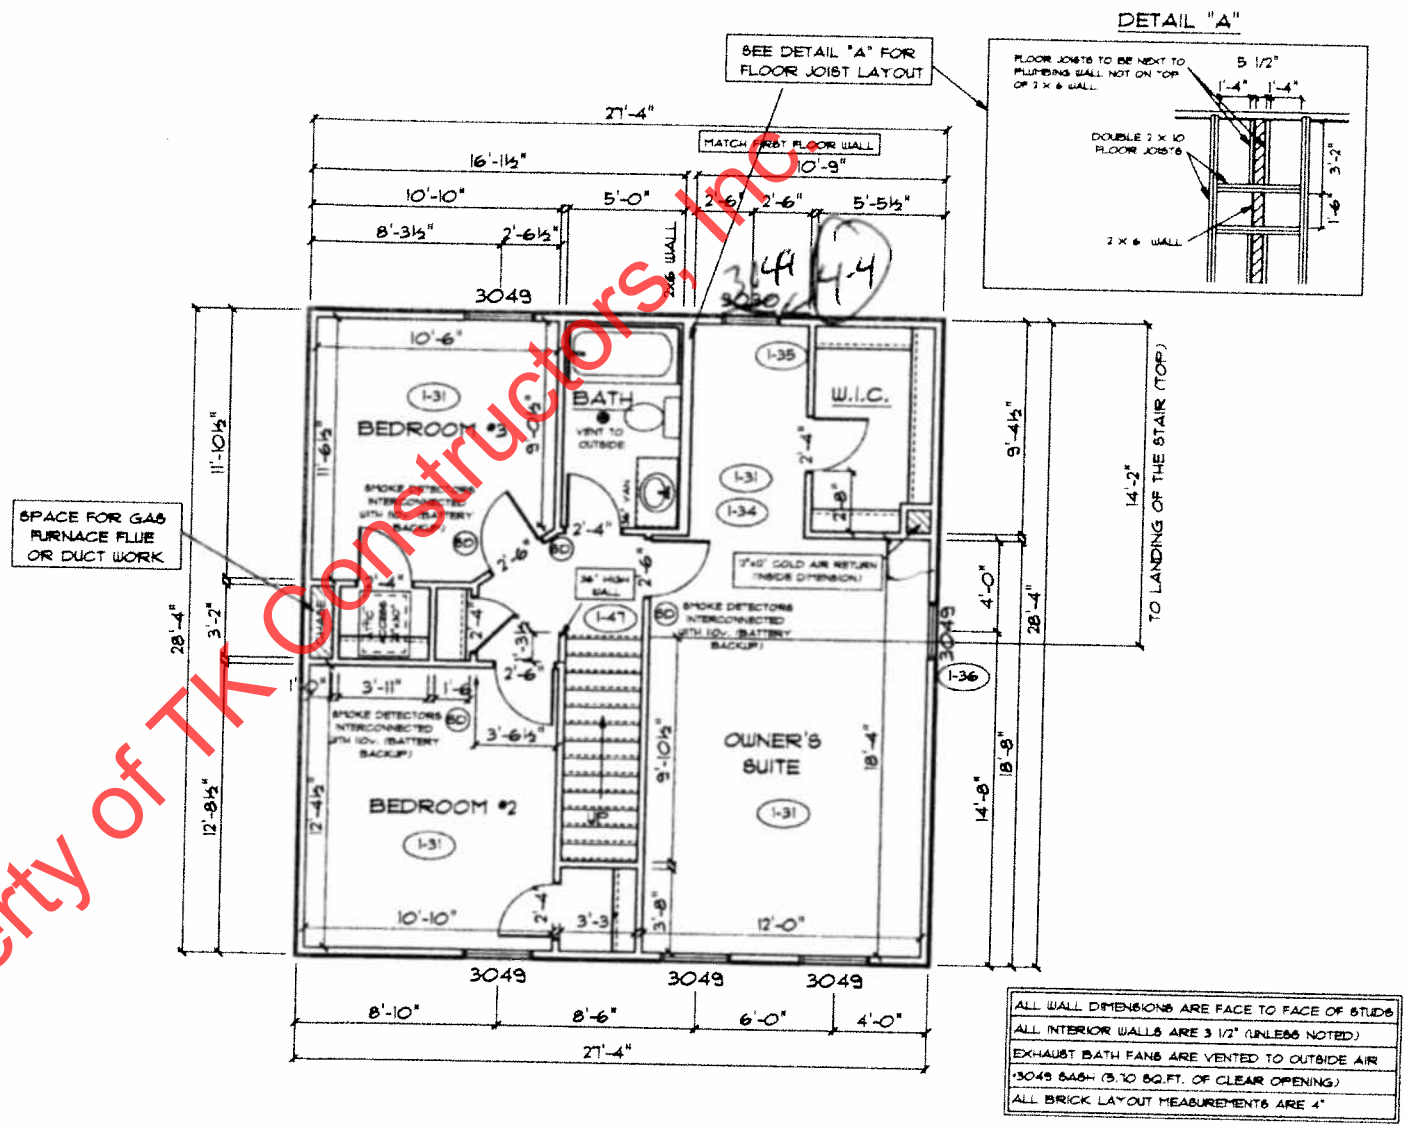

MIA