



marked up 5-12-14

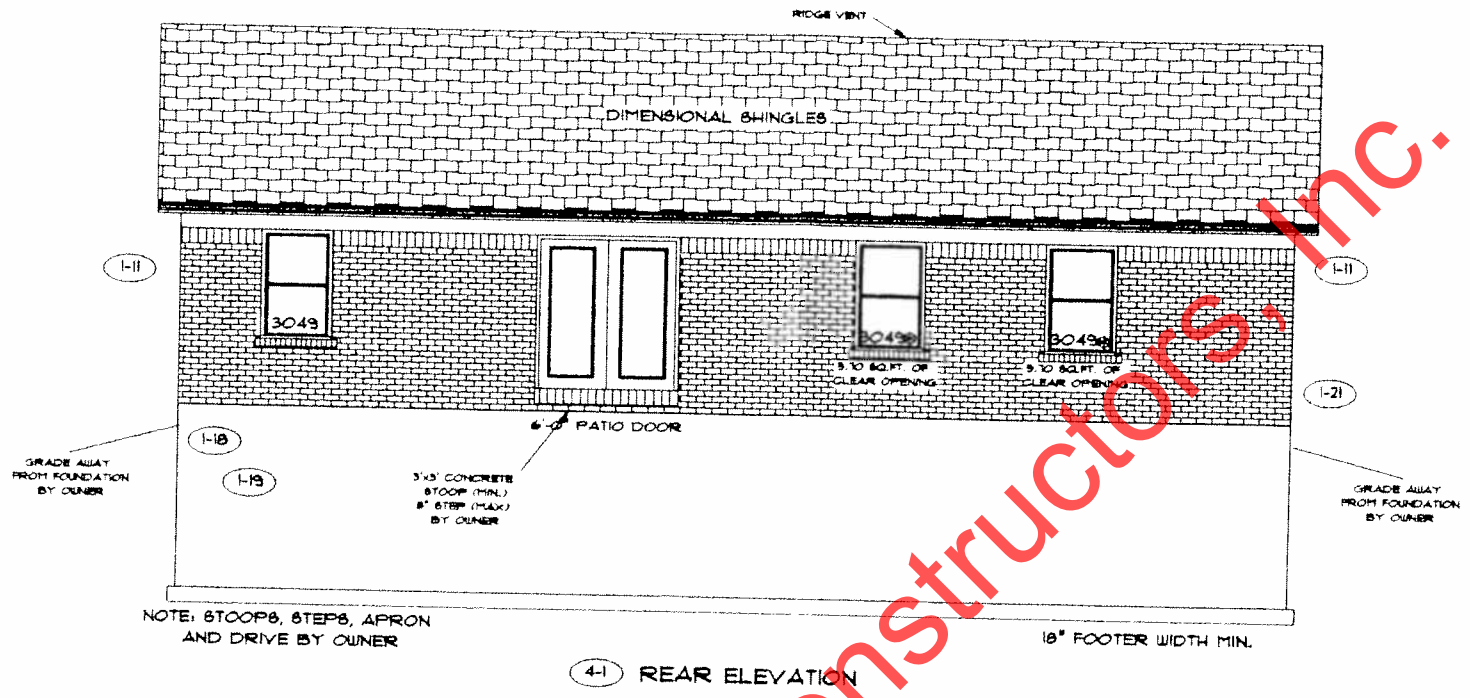

Property of TK Constructors, Inc.

PAGE NO:	1B
ADDENDUM 1.4	
VER:	01:44 PM
DRAWING BY:	RLC
	1/8" = 1'
DATE:	April 30, 2014
JOB NO:	212-14-0124

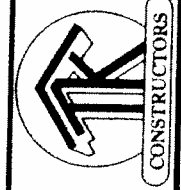

TK CONSTRUCTORS
GATLINBURG

Handwritten initials or signature.

4-1 FLOOR PLAN

Total Living Sq.ft.	1,254
Garage	464
Total Sq.ft.	1718
Excluding Porch	89

ANDERSEN WINDOW SCHEDULE
- 200 SERIES -

ANDERSEN MODEL NO.	R.O. SIZE
3030	36" x 36"
3040	36" x 48"
3049*	36" x 57"
3056*	36" x 66"
3060*	36" x 72"
3049 MULL*	73" x 57"
3056 MULL*	73" x 66"
3060 MULL*	73" x 72"
ANDERSEN SLIDING DOOR R.O. 72 3/4" x 82 1/8"	
3'-0" FRONT DOOR R.O. 38 3/8" x 82 1/2"	
3'-0" FRONT DOOR WITH (1) SIDELITE R.O. 51 1/8" x 82 1/2"	
3'-0" FRONT DOOR WITH (2) SIDELITES R.O. 65 3/8" x 82 1/2"	
R.O. FOR BI-FOLD DOORS USING DRYWALL JAMB FACING • 1 1/4" • DOOR SIZE x (81 1/2")	
R.O. FOR BYPASS DOORS USING DRYWALL JAMB FACING MAKE SAME AS BOTH DOORS ADDED TOGETHER	
ALL INTERIOR DOORS SIZE • 2" TO WIDTH x 82 1/2" HIGH	
R.O. POCKET DOOR (2x DOOR WIDTH • 1") x 85" HIGH	

* - DENOTES OPENING MEETS
EGRESS REQUIREMENTS

