

marked-up 3-6-13.

HAMPTON STANDARD OPTIONS
9'-0" FIRST FLOOR CEILING HEIGHT
DIRECT VENT FIREPLACE
QUICK IN CORNERS
8/12 PITCH HIP ROOF
SCHROCK RAISED PANEL OAK CABINETS
42" SMALL CABINETS
TRAY CEILING IN MASTER BEDROOM
COVERED REAR PORCH
3RD CAR GARAGE
LEVEL 2 BETTER CARPET AND PAD



REAR ELEVATION



FRONT ELEVATION

PAGE NO.: 10

ADDENDUM 1-4

VER: 092412

DRAWING BY: SES

SCALE: 1/8 IN.=1 FT.

DATE: December 17, 2012

JOB NO: 110-12-0094

TK CONSTRUCTORS

HAMPTON

DLP TOP

FLOOR PLAN

TOTAL LIVING SQ.FT.	2525
GARAGE	985
TOTAL SQ.FT.	3510
EXCLUDING PORCH	62
EXCLUDING PORCH	208

ANDERSEN WINDOW SCHEDULE - 200 SERIES -

ANDERSEN MODEL NO.	R.O. SIZE
3030	36" x 36"
3040	36" x 48"
3049*	36" x 57"
3056*	36" x 66"
3060*	36" x 72"
3049 MULL*	73" x 57"
3056 MULL*	73" x 66"
3060 MULL*	73" x 72"


ANDERSEN SLIDING DOOR R.O. 72 3/4" x 82 7/8"
3'-0" FRONT DOOR R.O. 38 3/8" x 82 1/2"
3'-0" FRONT DOOR WITH (1) SIDELITE R.O. 51 7/8" x 82 1/2"
3'-0" FRONT DOOR WITH (2) SIDELITES R.O. 65 3/8" x 82 1/2"
R.O. FOR BI-FOLD DOORS USING DRYWALL JAMB FACING = 1 1/4" + DOOR SIZE x (81 1/2")
R.O. FOR BYPASS DOORS USING DRYWALL JAMB FACING MAKE SAME AS BOTH DOORS ADDED TOGETHER
ALL INTERIOR DOORS SIZE + 2" TO WIDTH x 82 1/2" HIGH
R.O. POCKET DOOR (2x DOOR WIDTH + 1") x 85" HIGH

* - DENOTES OPENING MEETS EGRESS REQUIREMENTS

9'-0" FIRST FLOOR CEILING HEIGHT

INCLUDES:

- 4 1/4" BASEBOARDS IN LIEU OF 3 1/4"
- 3060 WINDOWS IN LIEU OF 3049 WINDOWS
- 3056 WINDOWS IN LIEU OF 3049 WINDOWS
- DRYWALL WRAPPED OPENINGS 12" TALLER
- 42" KITCHEN CABINETS STANDARD
- 16'x8' GARAGE DOOR STANDARD

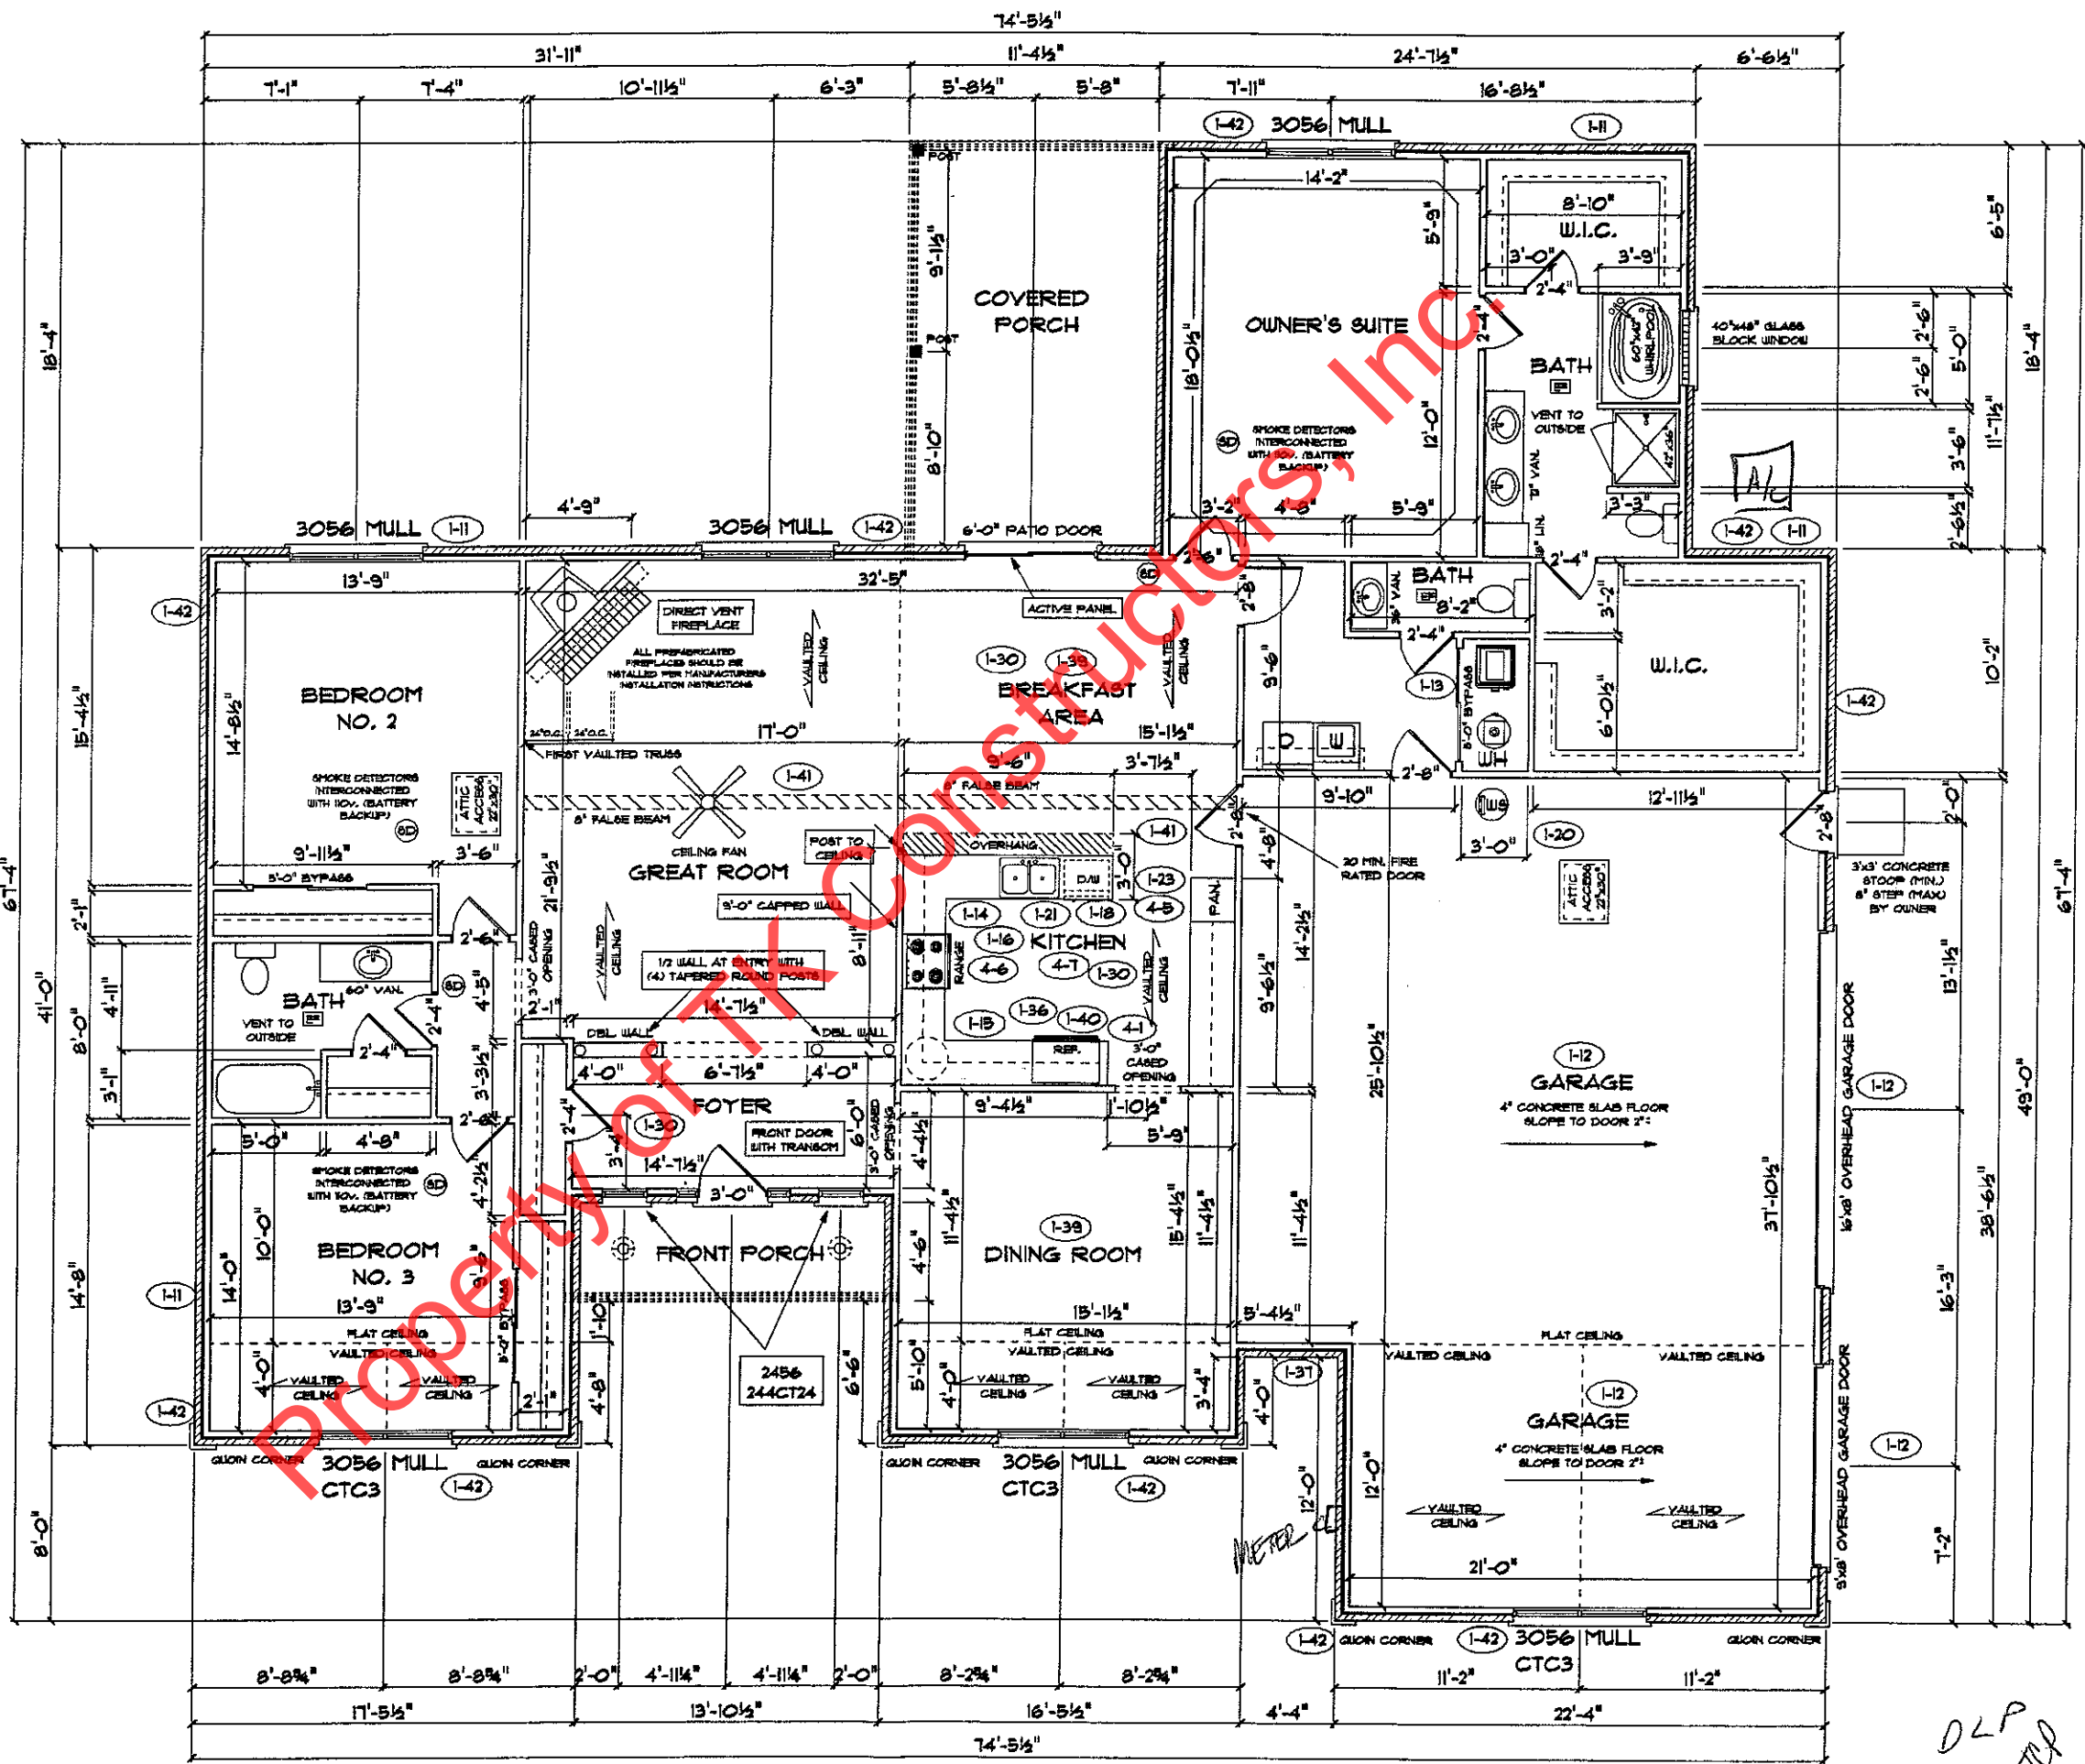

DLP
TRP

TK CONSTRUCTORS
HAMPTON

DATE: December 17, 2012
 ADDENDUM 1-4
 VER: 092412
 DRAWING BY: SES
 SCALE: 1/8 IN. = 1 FT.
 PAGE NO: 30
 JOB NO: 110-12-0094