



MARKED UP 6-24-14

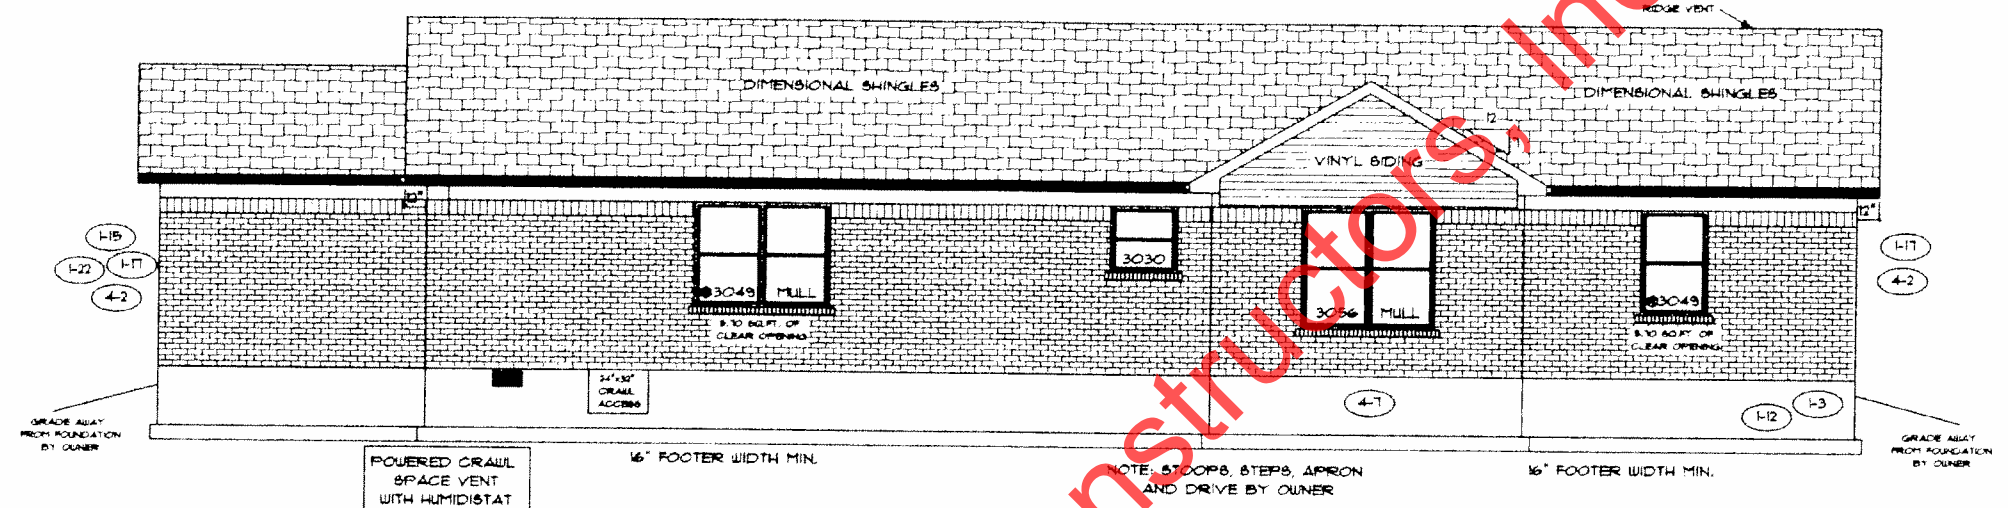

REAR ELEVATION

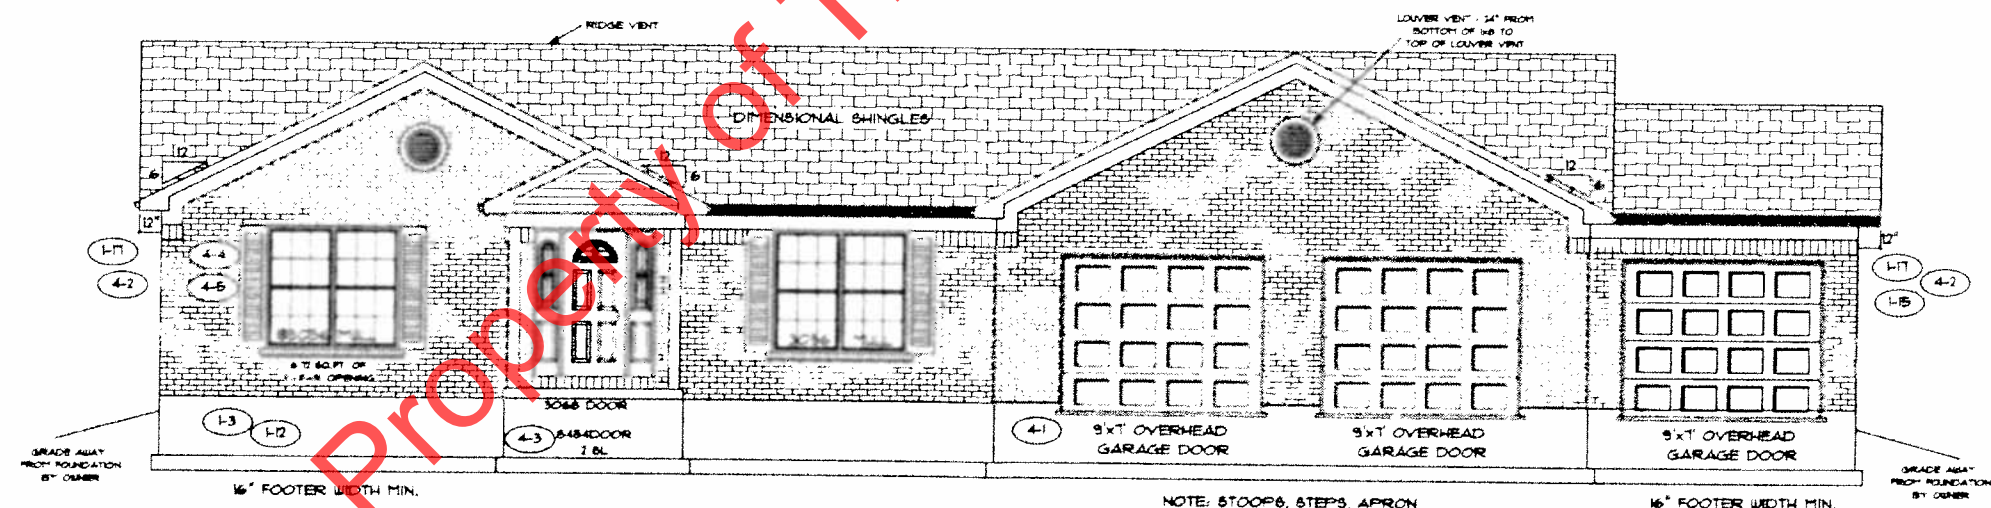

FRONT ELEVATION

PAGE NO.: 10

ADDENDUM I.4

VER. 092112

DRAWING BY: RLC

1/8" = 1'

DATE: April 22, 2014

JOB NO.: 210-14-0500

TK CONSTRUCTORS

MEMPHIS

M&G

5/6

2x6 EXTERIOR WALLS

1-21
FLOOR PLAN

TOTAL LIVING SQ.FT.	2,055
GARAGE	946
TOTAL SQ.FT.	3,001
EXCLUDING PORCH	32

ANDERSEN WINDOW SCHEDULE
- 200 SERIES -

ANDERSEN MODEL NO. R.O. SIZE

3030	36" x 36"
3040	36" x 48"
3049*	36" x 57"
3056*	36" x 66"
3060*	36" x 72"
3049 MULL*	73" x 57"
3056 MULL*	73" x 66"
3060 MULL*	73" x 72"

ANDERSEN SLIDING DOOR
R.O. 72 3/4" x 82 1/8"

3'-0" FRONT DOOR
R.O. 38 3/8" x 82 1/2"

3'-0" FRONT DOOR WITH (1) SIDELITE
R.O. 51 1/8" x 82 1/2"

3'-0" FRONT DOOR WITH (2) SIDELITES
R.O. 65 3/8" x 82 1/2"

R.O. FOR BI-FOLD DOORS USING DRYWALL
JAMB FACING + 1 1/4" + DOOR SIZE x (81 1/2")


R.O. FOR BYPASS DOORS USING DRYWALL
JAMB FACING MAKE SAME AS BOTH DOORS
ADDED TOGETHER

ALL INTERIOR DOORS
SIZE + 2" TO WIDTH x 82 1/2" HIGH

R.O. POCKET DOOR
(2x DOOR WIDTH + 1") x 85" HIGH

* - DENOTES OPENING MEETS
EGRESS REQUIREMENTS

ALL WALL DIMENSIONS ARE FACE TO FACE OF STUDS
ALL INTERIOR WALLS ARE 3 1/2" (UNLESS NOTED)
EXHAUST BATH FANS ARE VENTED TO OUTSIDE AIR
*3049 SASH (6'10" SQ.FT. OF CLEAR OPENING)
ALL BRICK LAYOUT MEASUREMENTS ARE 4"

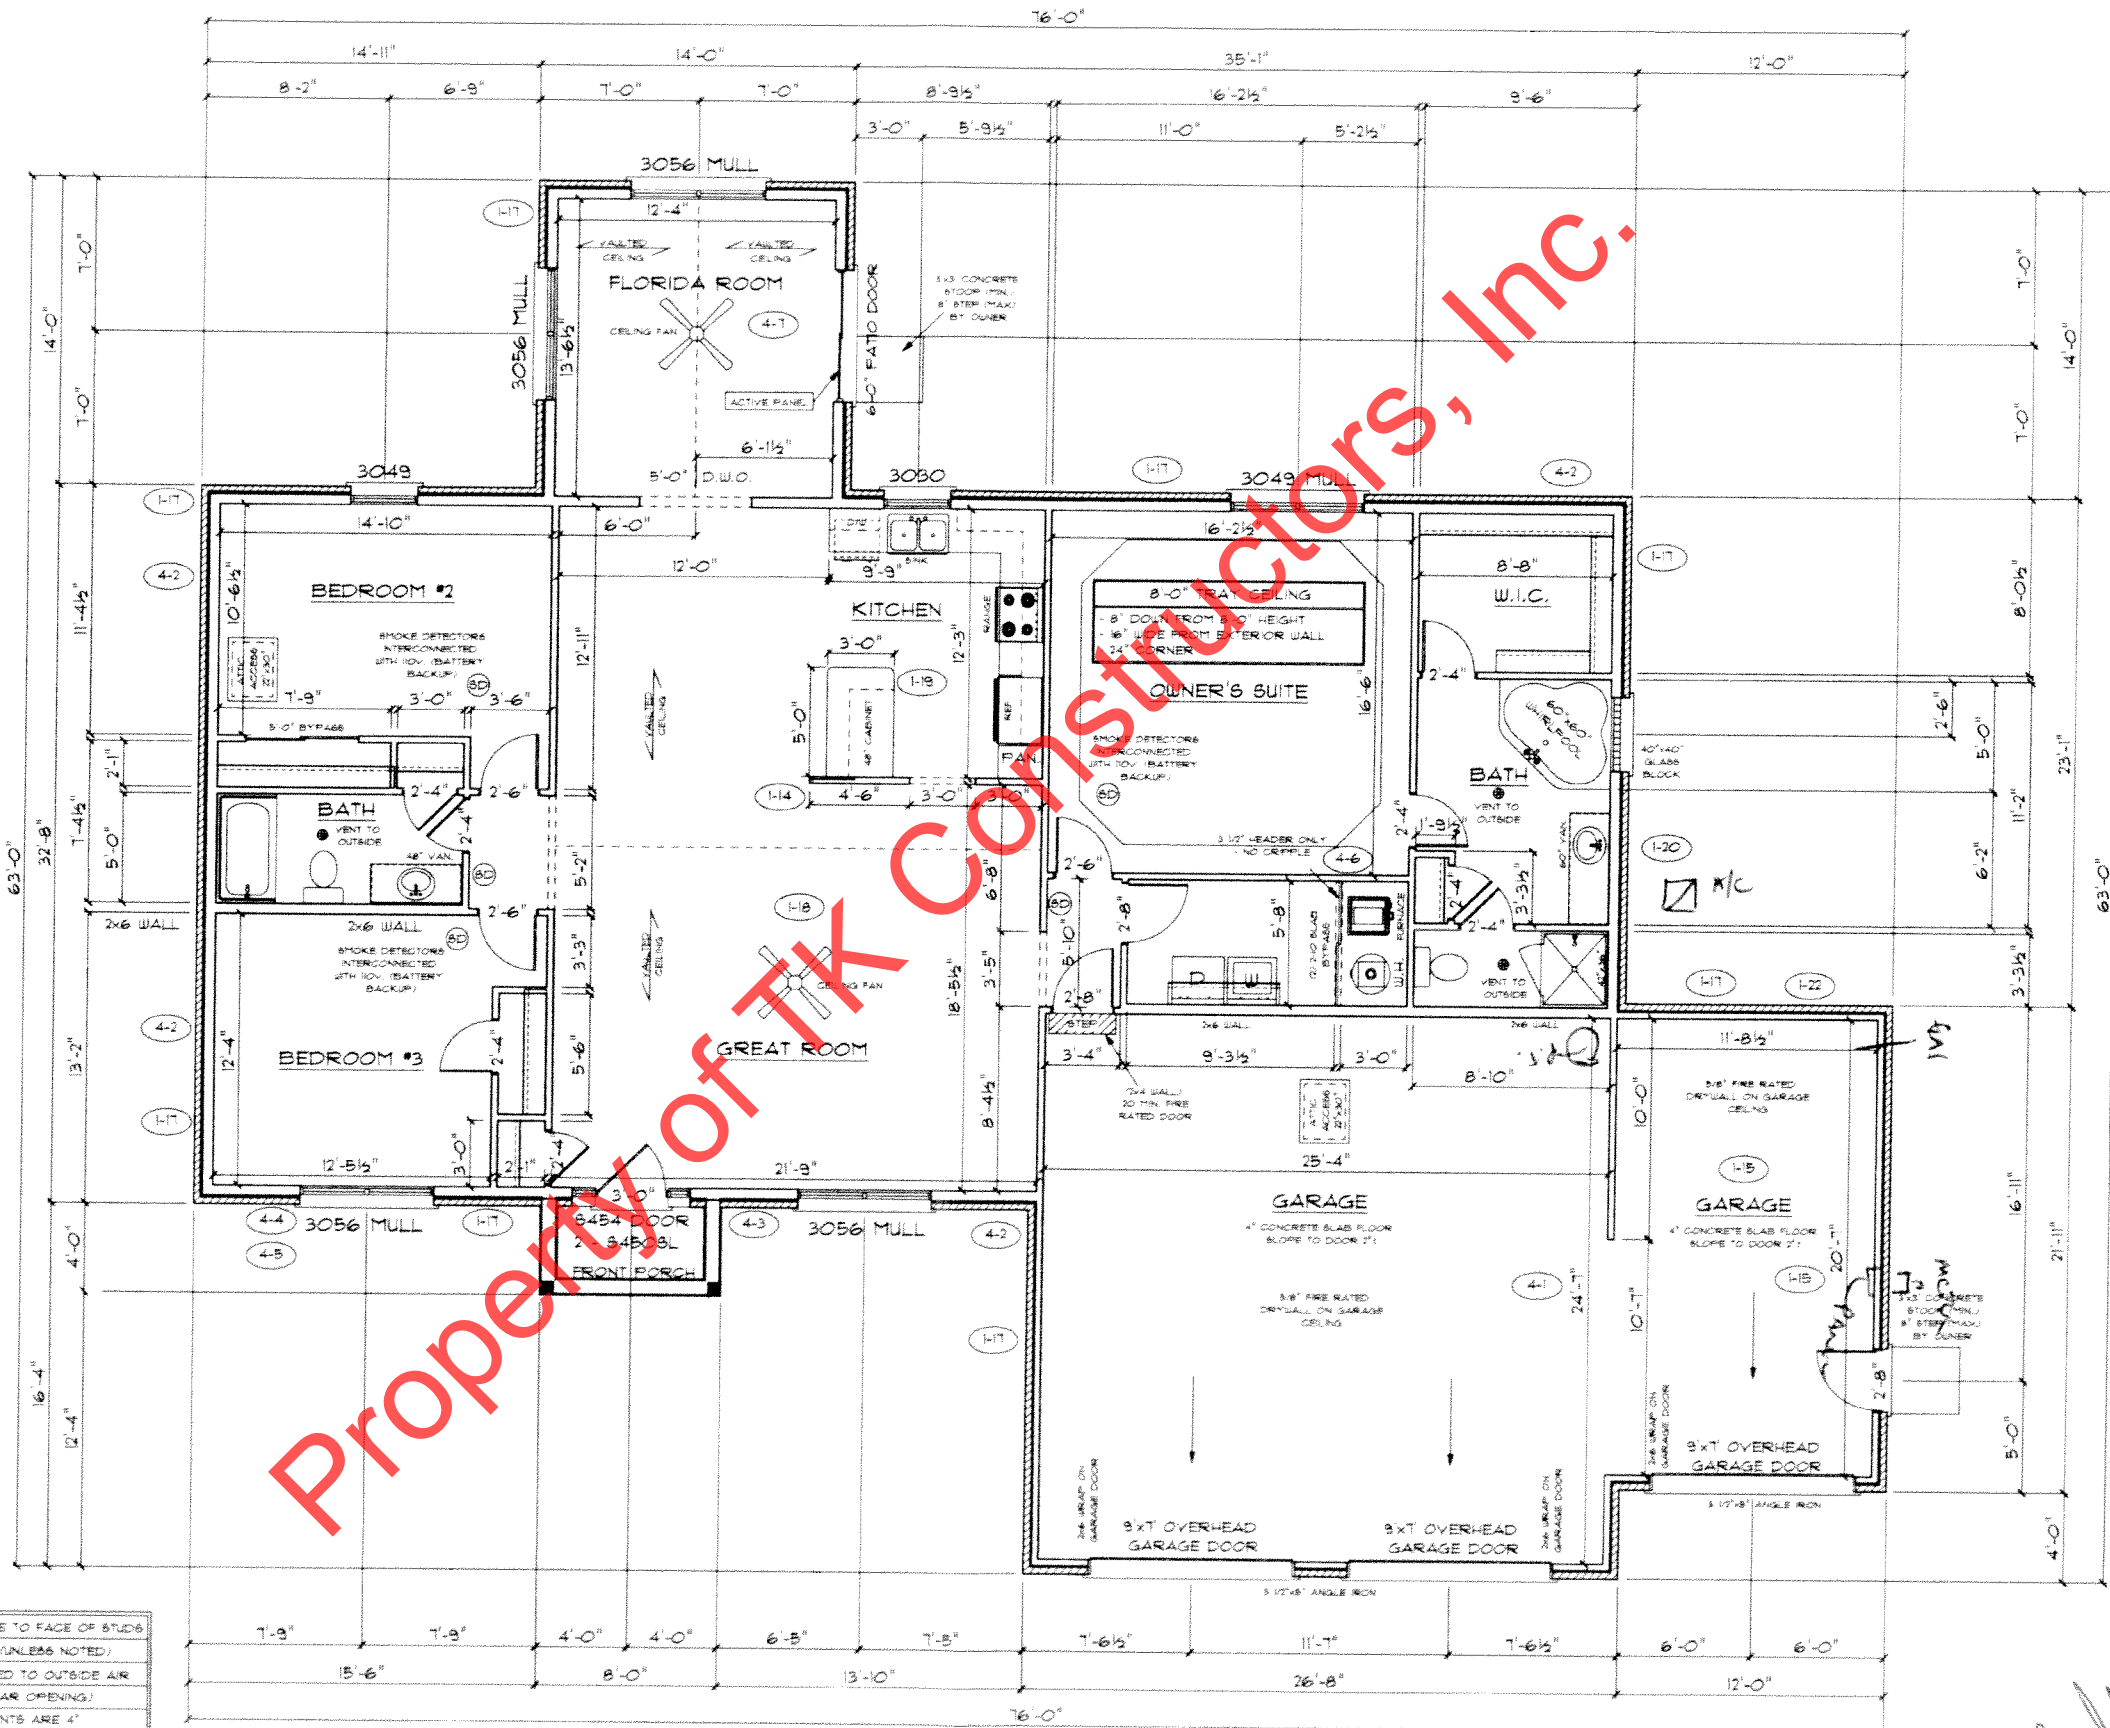

Property of TK Constructors, Inc.



CONSTRUCTORS

TK CONSTRUCTORS

MEMPHIS

[Handwritten signature]