

REAR ELEVATION



FRONT ELEVATION

PAGE NO: **1B**
 ADDENDUM 1,4,5,6
 VER: 03:13 PM
 DRAWING BY: SES
 1/8" = 1'
 DATE: August 06, 2013
 JOB NO: 110-13-0060

TK CONSTRUCTORS
NEW ORLEANS

ALM
 RM

FLOOR PLAN


TOTAL LIVING SQ.FT.	2,490
GARAGE	933
TOTAL SQ.FT.	3,423
EXCLUDING PORCH	208

ANDERSEN WINDOW SCHEDULE
- 400 SERIES - (180)

ANDERSEN MODEL NO.	R.O. SIZE
TW30210	38 1/8" x 36 7/8"
TW30310	38 1/8" x 48 7/8"
TW3046	38 1/8" x 56 7/8"
TW3056	38 1/8" x 68 7/8"
TW30510	38 1/8" x 72 7/8"
TW3046 - 2	76 1/8" x 56 7/8"
TW3056 - 2	76 1/8" x 68 7/8"
TW30510 - 2	76 1/8" x 72 7/8"
ANDERSEN SLIDING DOOR R.O. 72 3/4" x 82 7/8"	
3'-0" FRONT DOOR R.O. 38 3/8" x 82 1/2"	
3'-0" FRONT DOOR WITH (1) SIDELITE R.O. 51 7/8" x 82 1/2"	
3'-0" FRONT DOOR WITH (2) SIDELITES R.O. 65 3/8" x 82 1/2"	
R.O. FOR BI-FOLD DOORS USING DRYWALL JAMB FACING + 1 1/4" + DOOR SIZE x (81 1/2")	
R.O. FOR BYPASS DOORS USING DRYWALL JAMB FACING MAKE SAME AS BOTH DOORS ADDED TOGETHER	
ALL INTERIOR DOORS SIZE + 2" TO WIDTH x 82 1/2" HIGH	
R.O. POCKET DOOR (2x DOOR WIDTH + 1") x 85" HIGH	

-- DENOTES OPENING MEETS
EGRESS REQUIREMENTS

ALL WALL DIMENSIONS ARE FACE TO FACE OF STUDS
ALL INTERIOR WALLS ARE 3 1/2" (UNLESS NOTED)
EXHAUST BATH FANS ARE VENTED TO OUTSIDE AIR
13049 SASH (5.70 SQ.FT. OF CLEAR OPENING)
ALL BRICK LAYOUT MEASUREMENTS ARE 4"

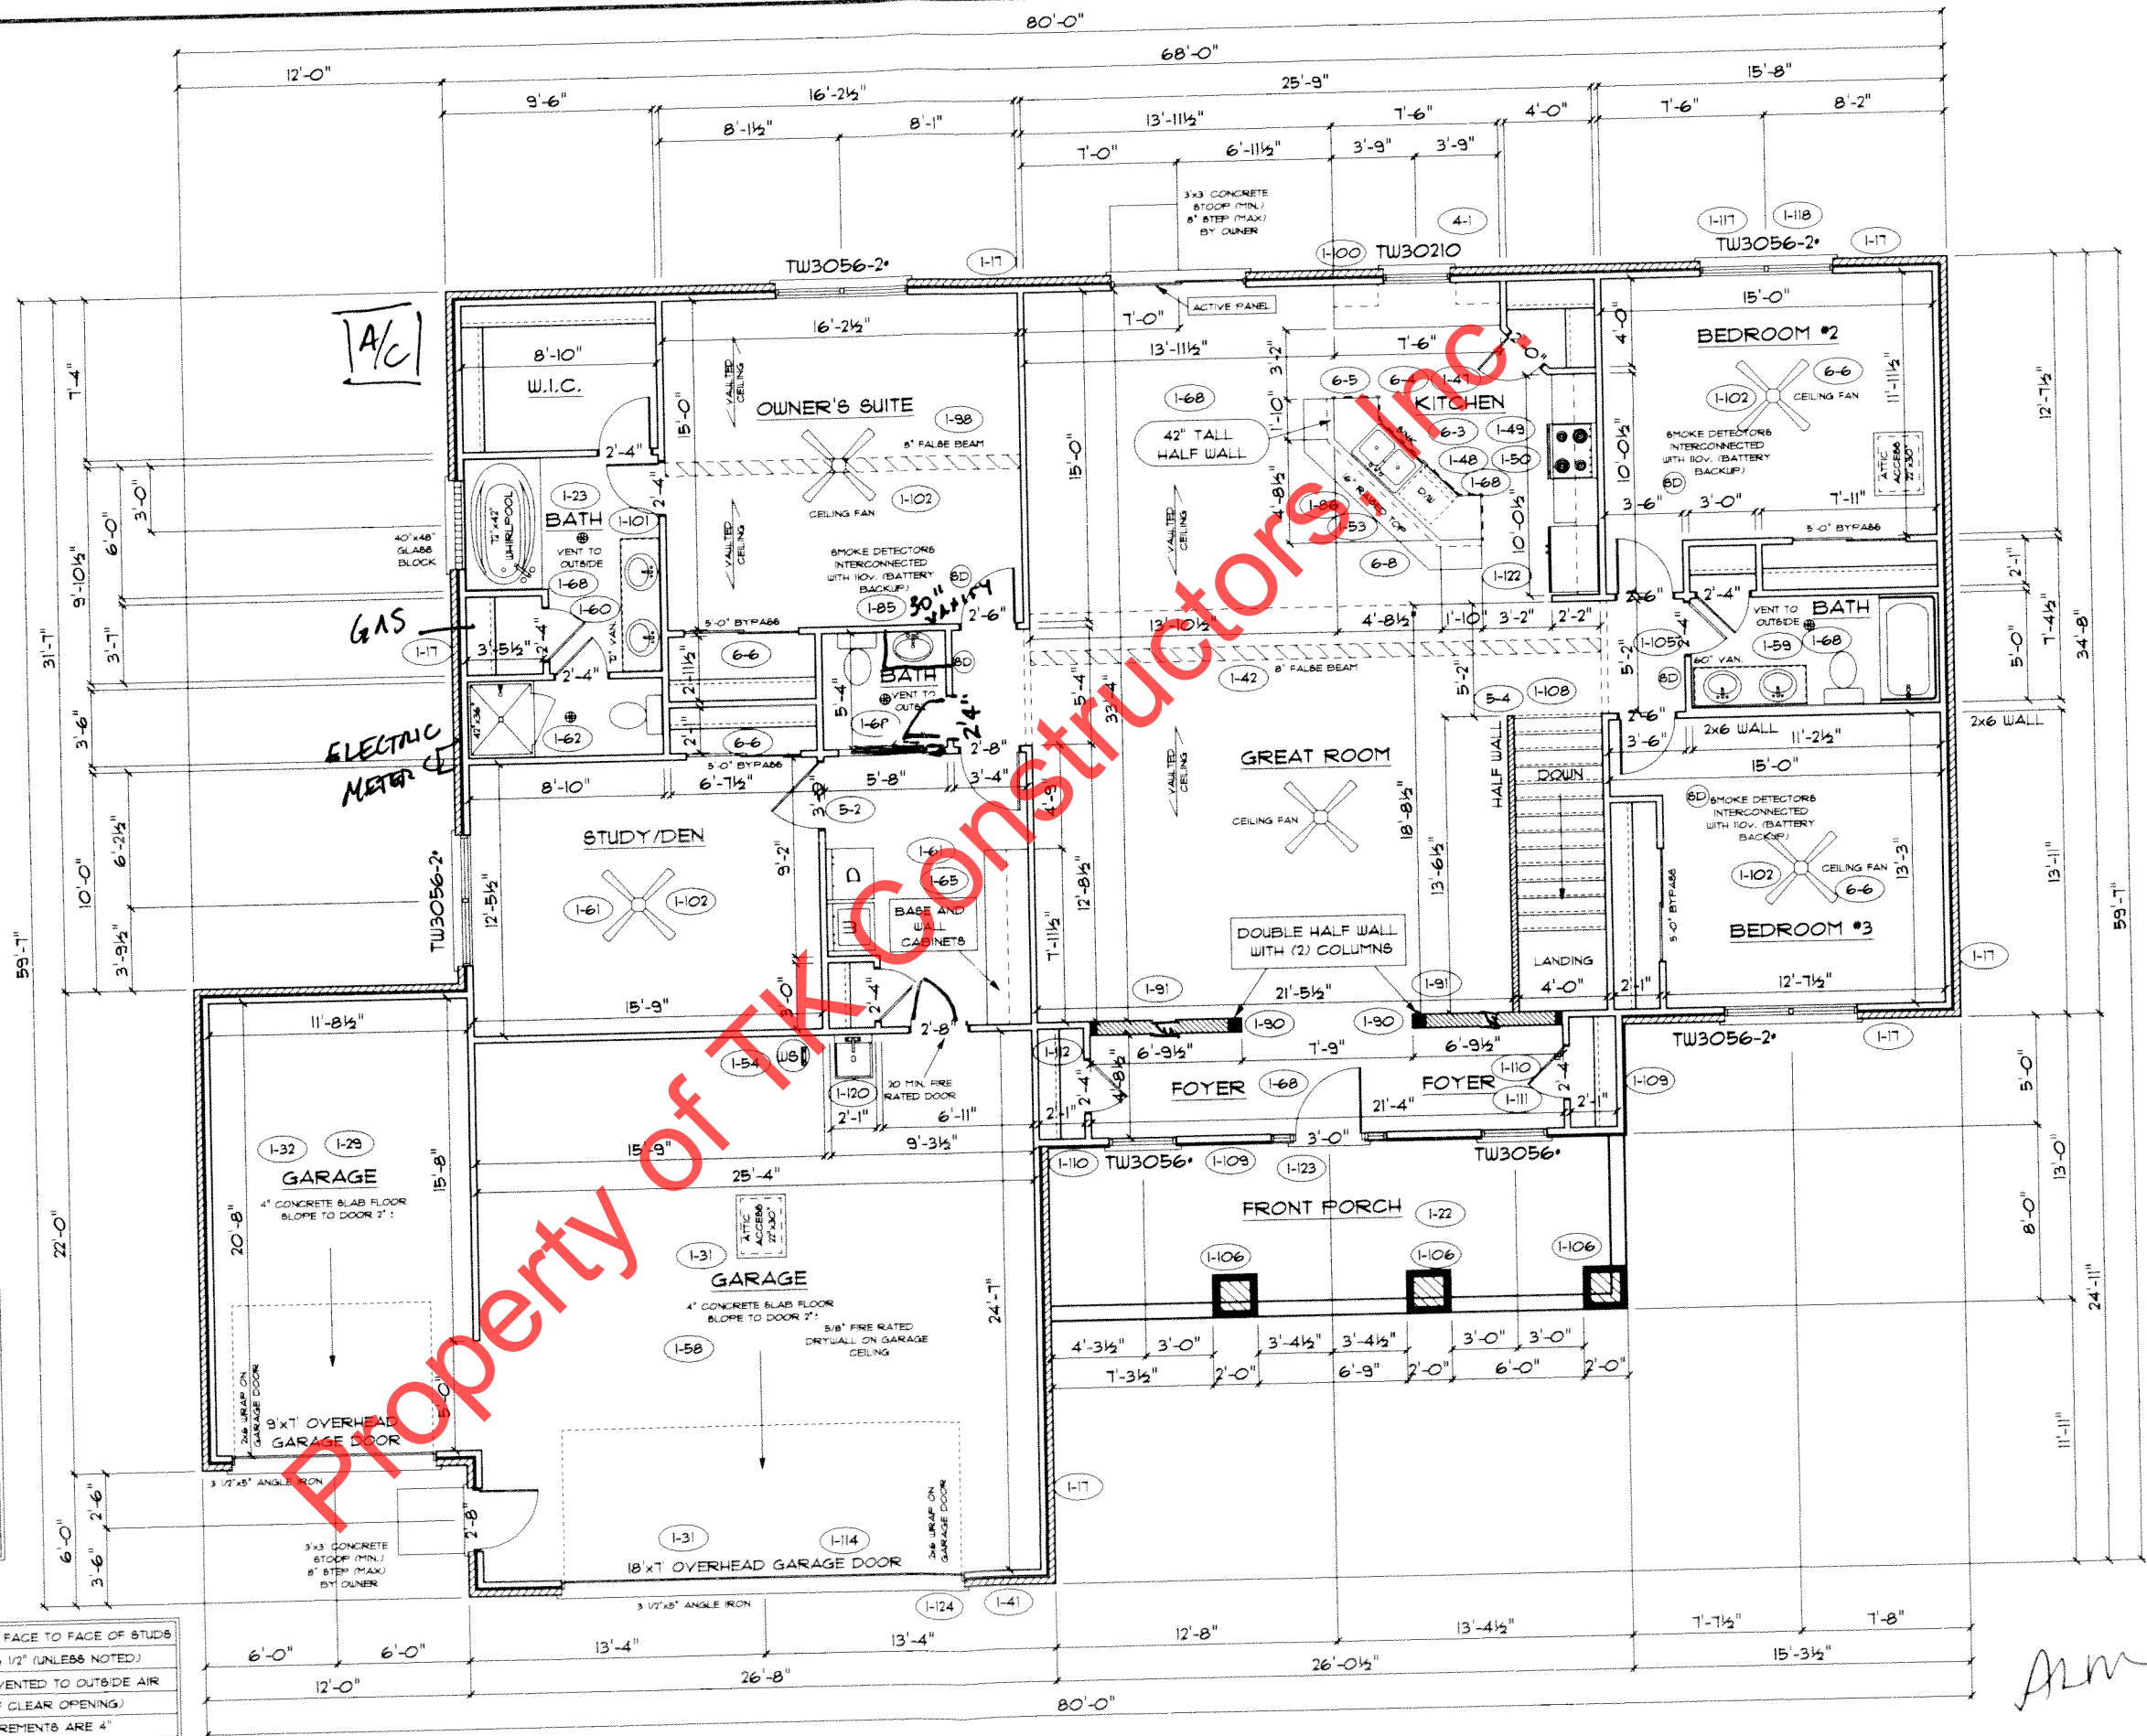

ALM
AM

