

marked up For P.O.'s

5-1-16

PAGE NO: 10


ADDENDUM 1  
VER: 09:33 AM  
DRAWING BY: NL, GW  
1/8" = 1'



DATE: May 26, 2016

JOB NO.: 210-16-0211

TK CONSTRUCTORS  
MONTGOMERY

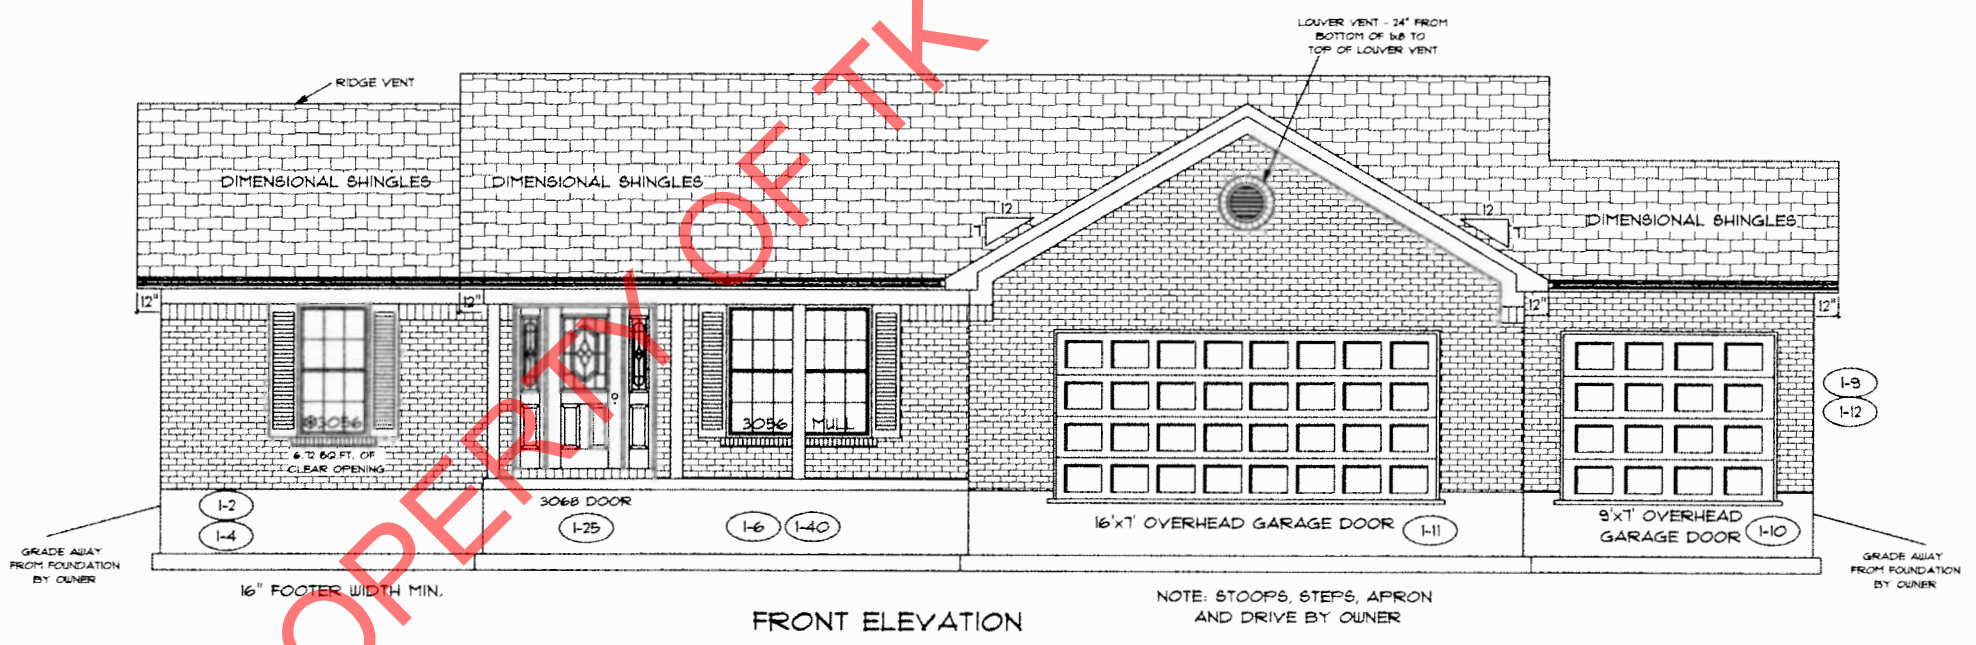

PROPERITY OF TK CONSTRUCTORS, INC

FLOOR PLAN


TOTAL LIVING SQ.FT.	1,739
GARAGE	737
TOTAL SQ.FT.	2,476
EXCLUDING PORCH	120

ANDERSEN WINDOW SCHEDULE  
- 200 SERIES -

ANDERSEN MODEL NO.	R.O. SIZE
3030	36" x 36"
3040	36" x 48"
3049*	36" x 57"
3056*	36" x 66"
3060*	36" x 72"
3049 MULL*	73" x 57"
3056 MULL*	73" x 66"
3060 MULL*	73" x 72"
ANDERSEN SLIDING DOOR R.O. 12 3/4" x 82 1/8"	(1-5)
3'-0" FRONT DOOR R.O. 38 3/8" x 82 1/2"	(1-25)
3'-0" FRONT DOOR WITH (1) SIDELITE R.O. 51 1/8" x 82 1/2"	
3'-0" FRONT DOOR WITH (2) SIDELITES R.O. 65 3/8" x 82 1/2"	
R.O. FOR BI-FOLD DOORS USING DRYWALL JAMB FACING = 1 1/4" + DOOR SIZE x (81 1/2")	
R.O. FOR BYPASS DOORS USING DRYWALL JAMB FACING MAKE SAME AS BOTH DOORS ADDED TOGETHER	
ALL INTERIOR DOORS SIZE + 2" TO WIDTH x 82 1/2" HIGH	
R.O. POCKET DOOR (2x DOOR WIDTH + 1") x 85" HIGH	

\* - DENOTES OPENING MEETS  
EGRESS REQUIREMENTS

ALL WALL DIMENSIONS ARE FACE TO FACE OF STUDS  
ALL INTERIOR WALLS ARE 3 1/2" (UNLESS NOTED)  
EXHAUST BATH FANS ARE VENTED TO OUTSIDE AIR  
\*3049 SASH (5.70 SQ.FT. OF CLEAR OPENING)  
ALL BRICK LAYOUT MEASUREMENTS ARE 4"

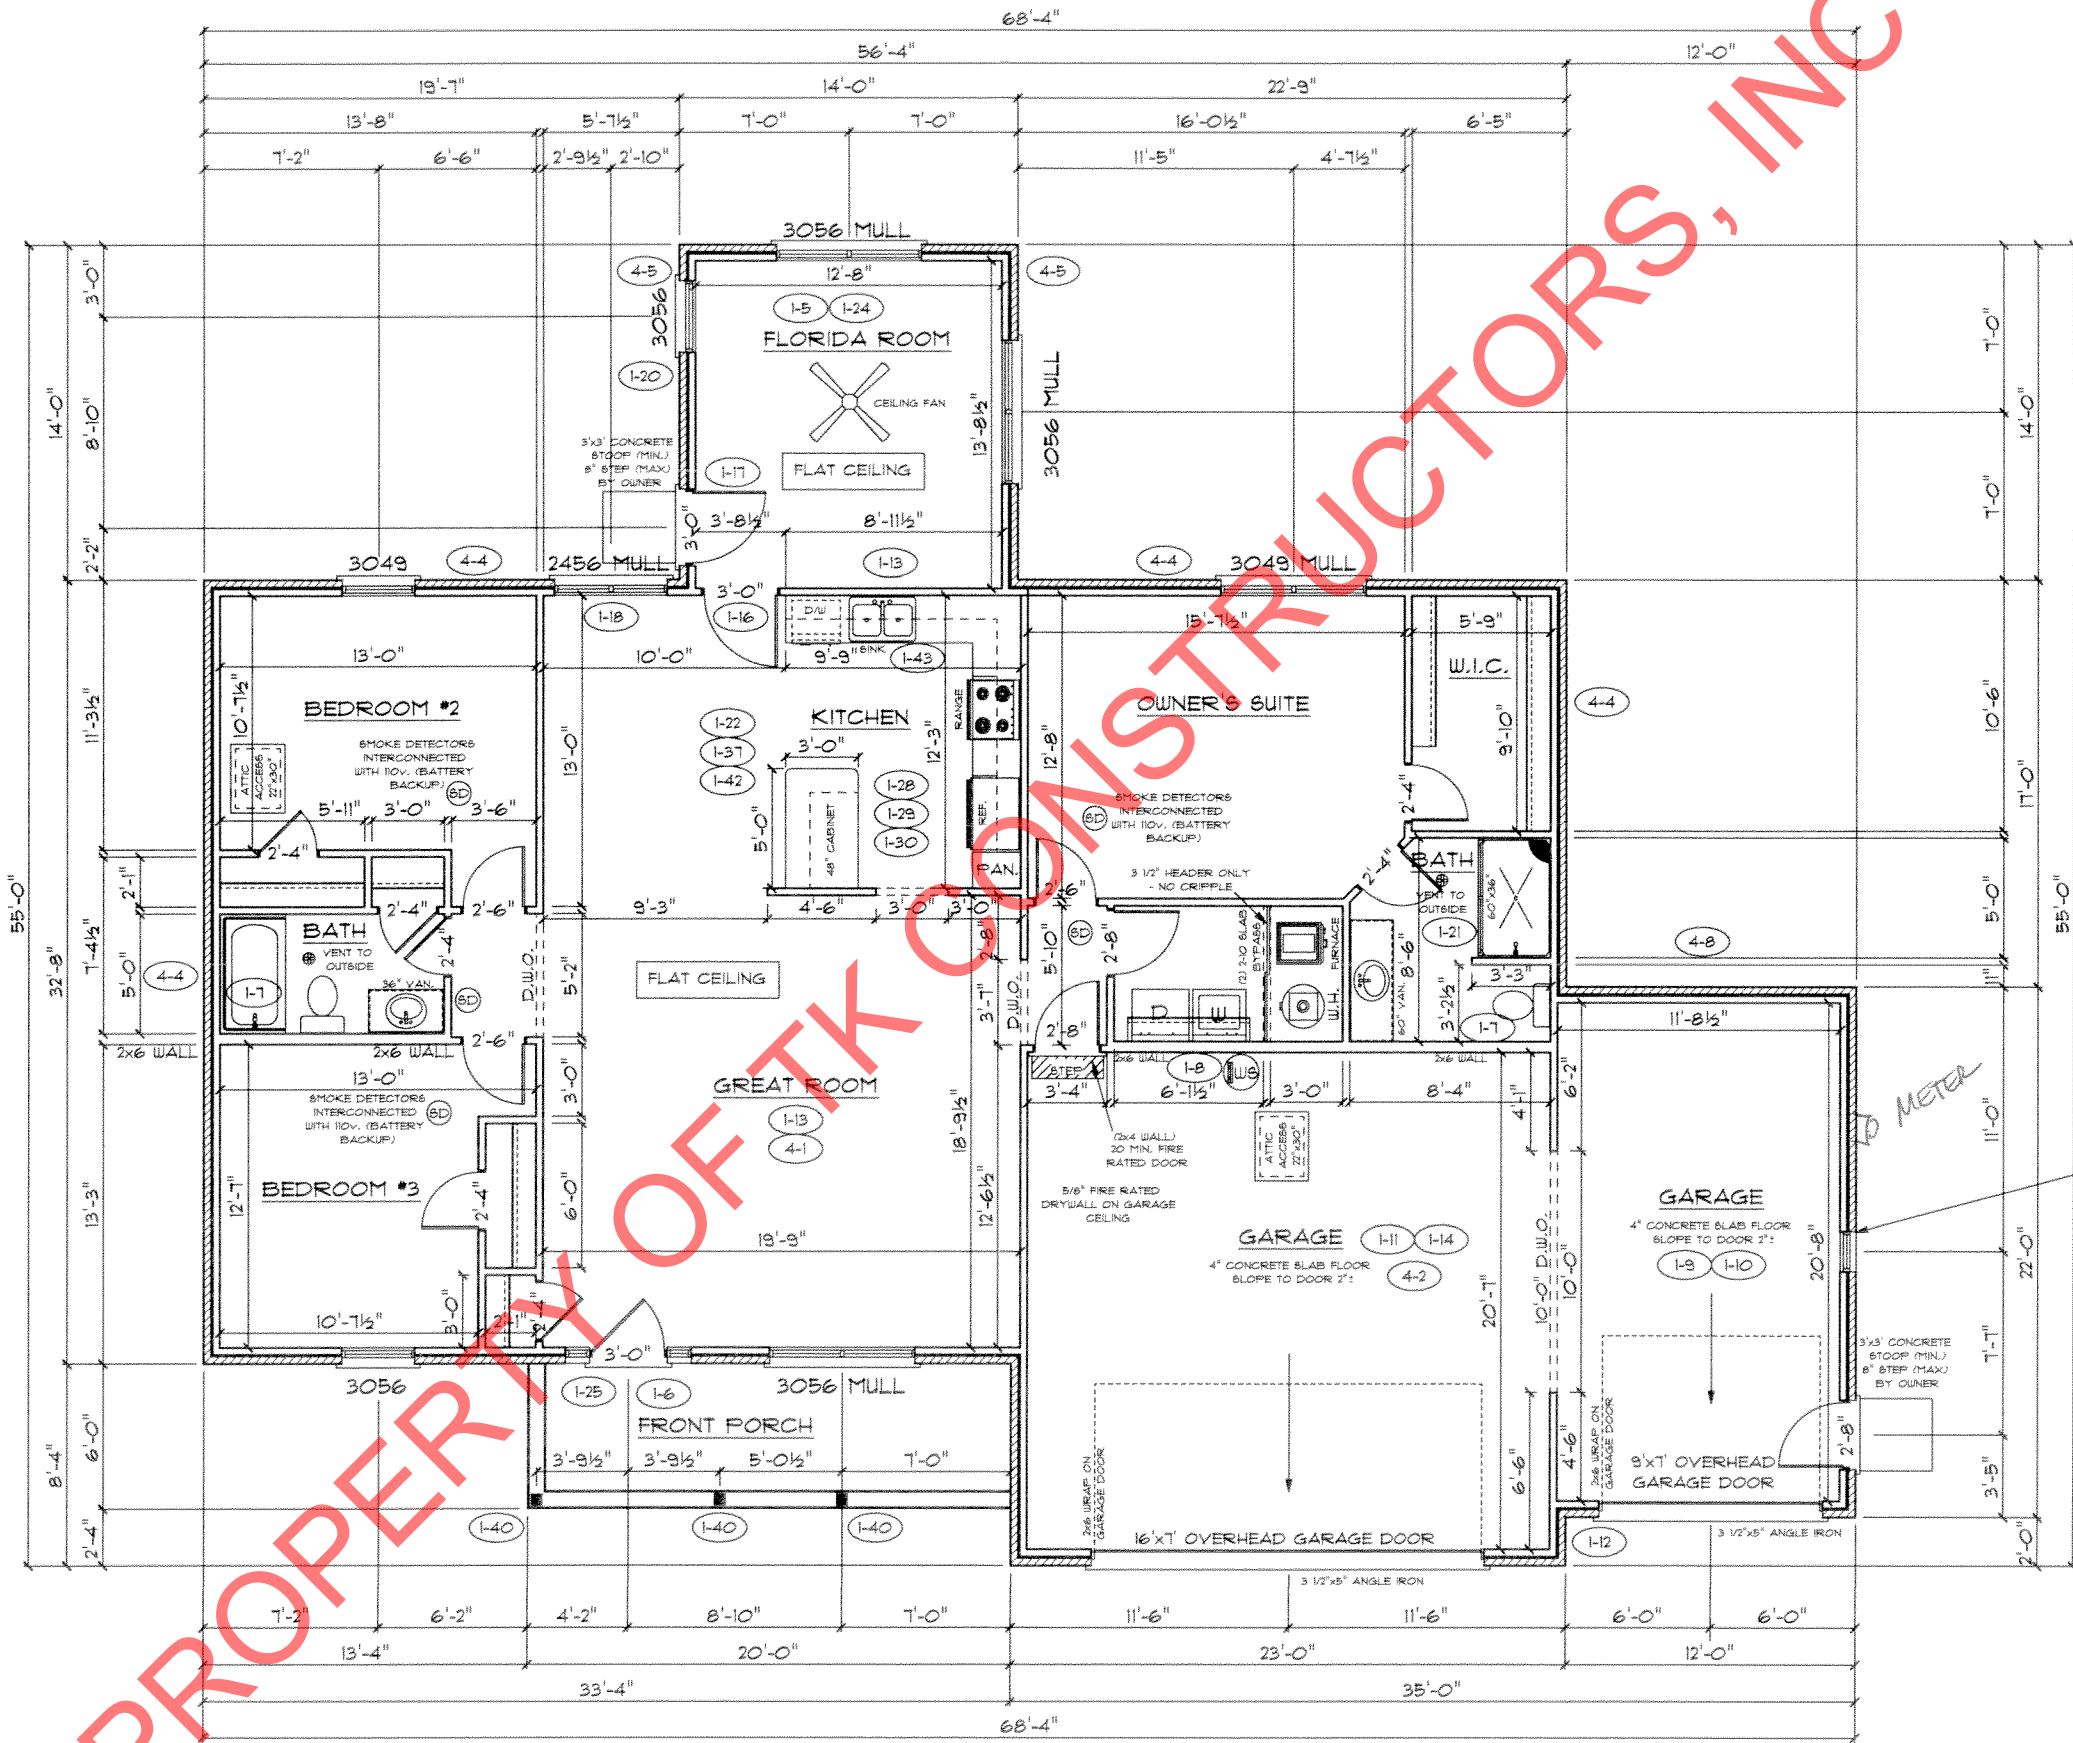

PROPERLY OFFK

TK CONSTRUCTORS, INC

TK CONSTRUCTORS  
MONTGOMERY

ADDENDUM 1  
VER: 09:33 AM  
DRAWING BY: NL, GW  
1/8" = 1'

DATE: May 26, 2016  
JOB NO: 210-16-0211

PAGE NO: 3C