

PAGE NO: 10

ADDENDUM 1

VER: 092412

DRAWING BY: SES

SCALE: 1/8" = 1 FT.


DATE: October 19, 2012

JOB NO: 110-12-0031

TK CONSTRUCTORS  
NEW ORLEANS

*[Handwritten signature]*

20" OCTAGON WINDOW (6'-4" OFF FLOOR TO TOP OF WINDOW)

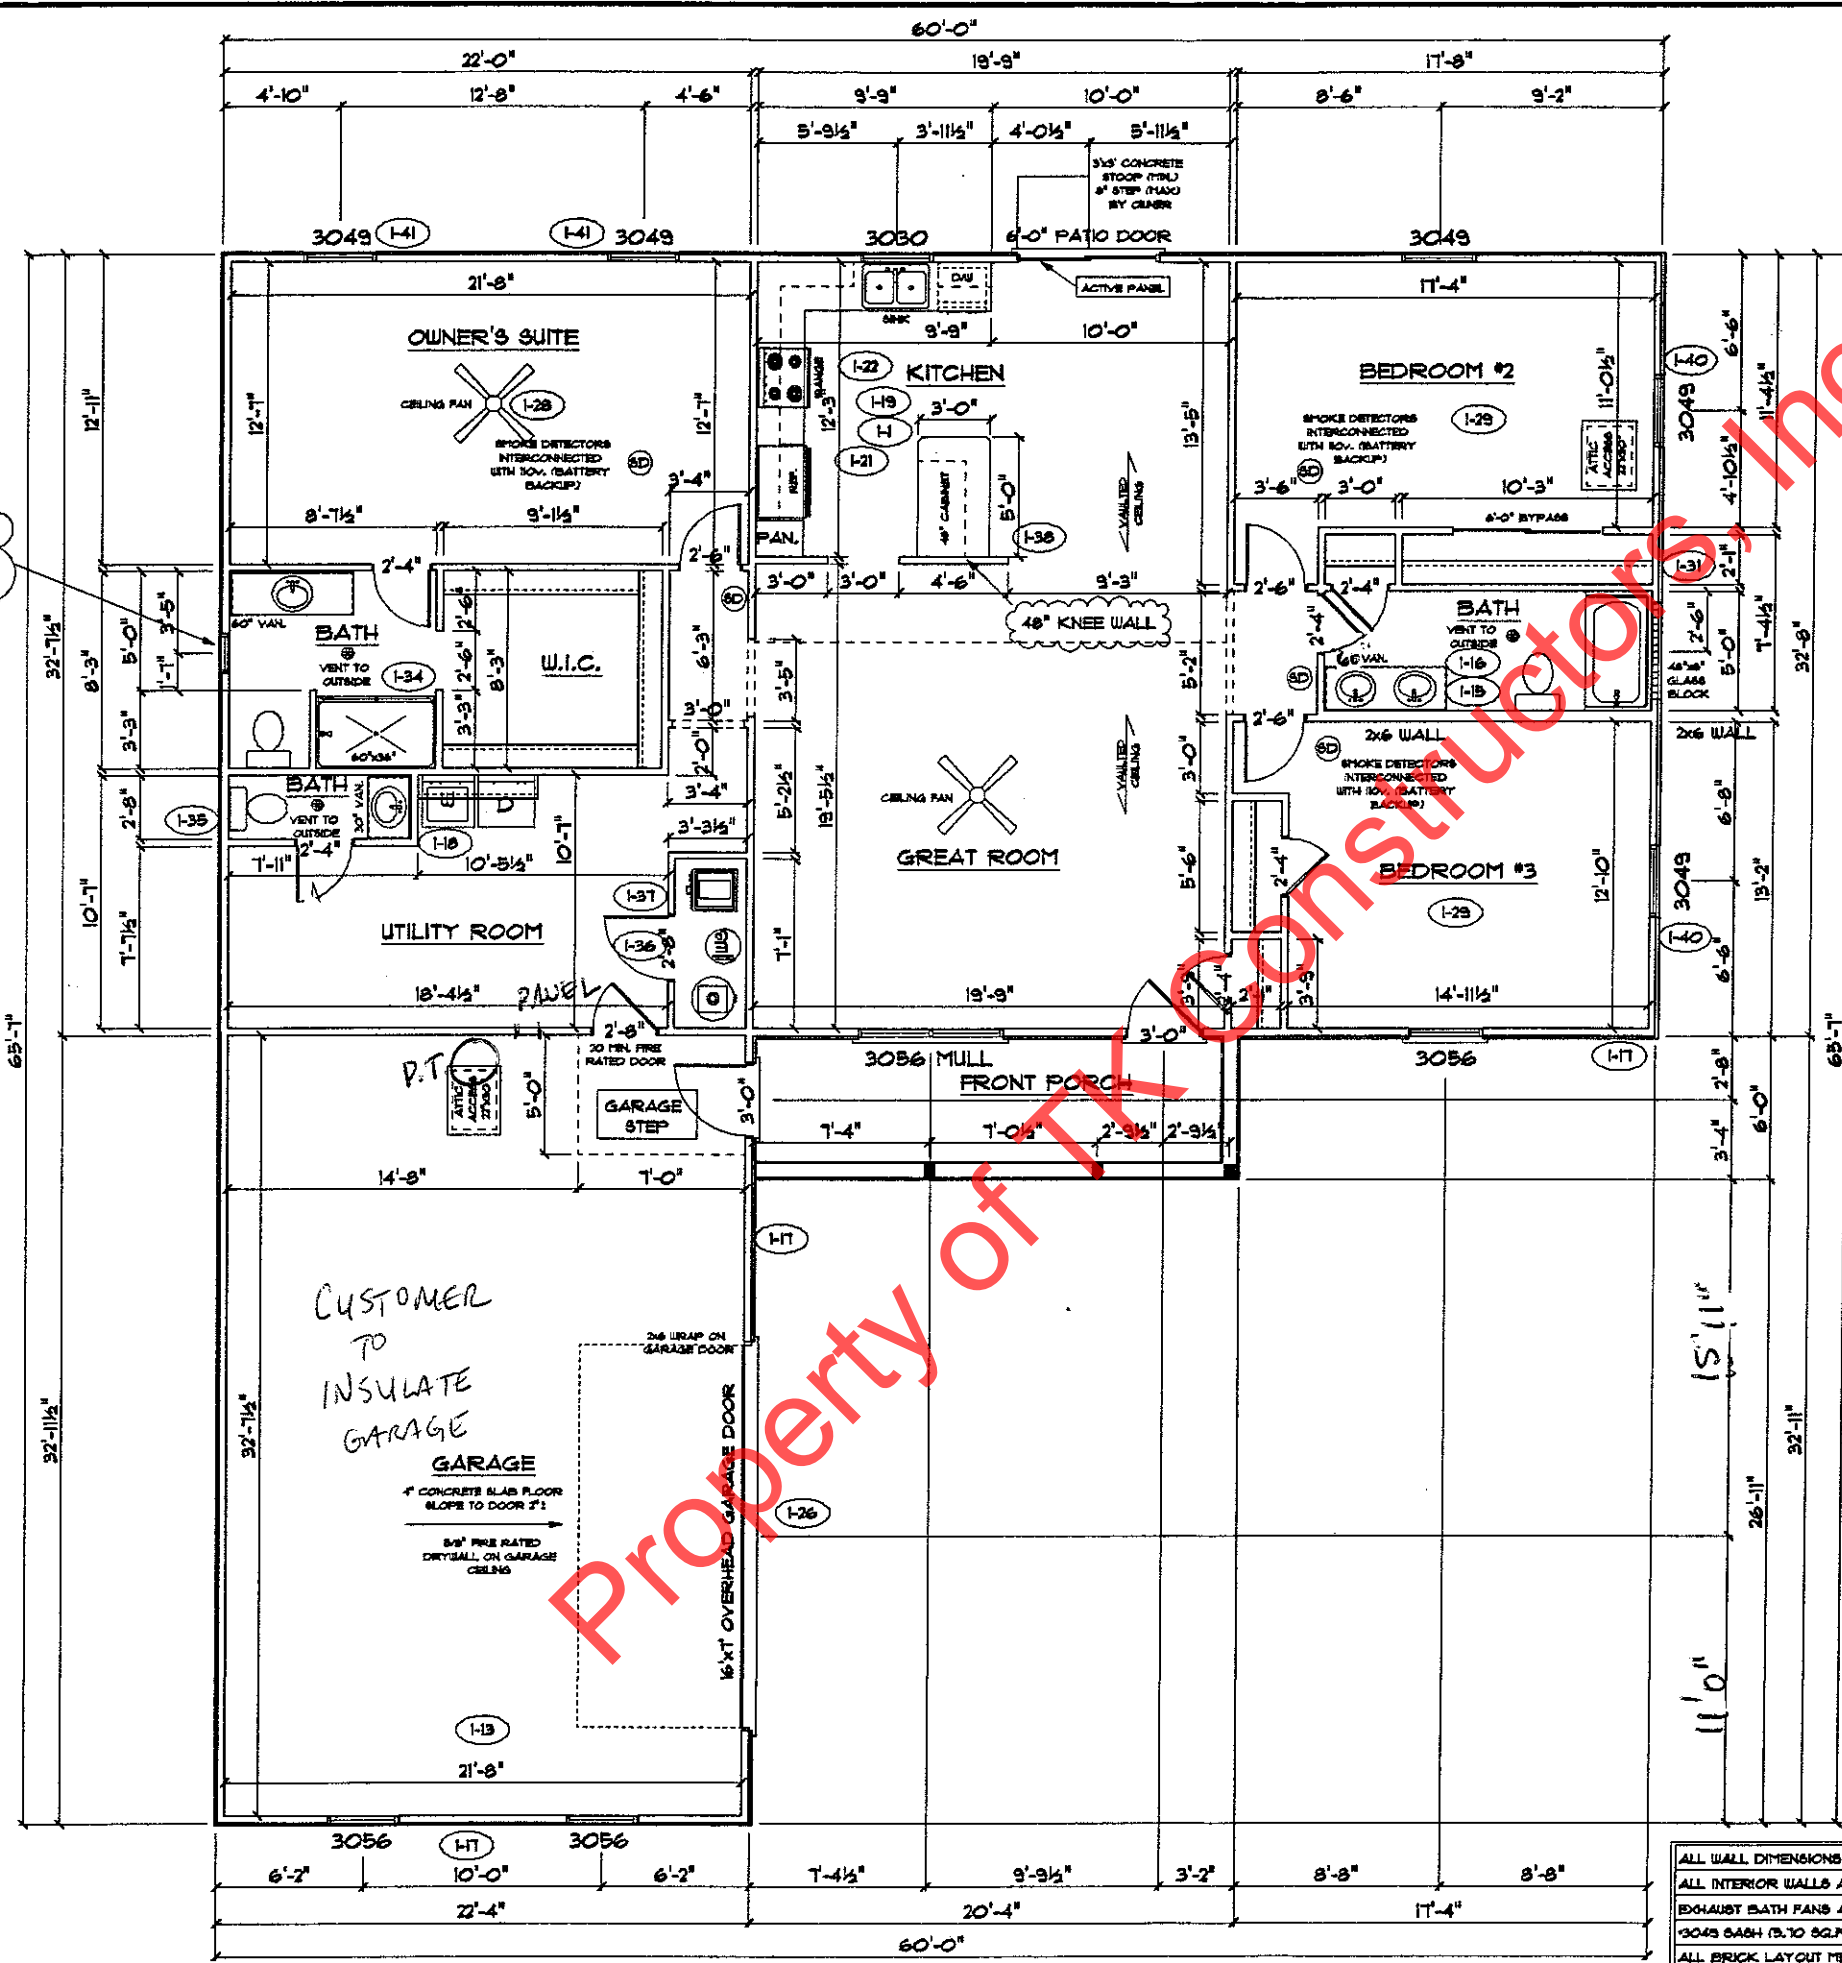

FLOOR PLAN

TOTAL LIVING SQ.FT.	1960
GARAGE	735
TOTAL SQ.FT.	2,695
EXCLUDING PORCH	122

ANDERSEN WINDOW SCHEDULE - 200 SERIES -	
ANDERSEN MODEL NO.	R.O. SIZE
3030	36" x 36"
3040	36" x 48"
3049*	36" x 51"
3056*	36" x 66"
3060*	36" x 72"
3049 MULL*	73" x 51"
3056 MULL*	73" x 66"
3060 MULL*	73" x 72"
ANDERSEN SLIDING DOOR R.O. 72 3/4" x 82 1/8"	
3'-0" FRONT DOOR R.O. 38 3/8" x 82 1/2"	
3'-0" FRONT DOOR WITH (1) SIDELITE R.O. 51 7/8" x 82 1/2"	
3'-0" FRONT DOOR WITH (2) SIDELITES R.O. 65 3/8" x 82 1/2"	
R.O. FOR BI-FOLD DOORS USING DRYWALL JAMB FACING = 1 1/4" + DOOR SIZE x (81 1/2")	
R.O. FOR BYPASS DOORS USING DRYWALL JAMB FACING MAKE SAME AS BOTH DOORS ADDED TOGETHER	
ALL INTERIOR DOORS SIZE + 2" TO WIDTH x 82 1/2" HIGH	
R.O. POCKET DOOR (2x DOOR WIDTH + 1") x 85" HIGH	

ALL WALL DIMENSIONS ARE FACE TO FACE OF STUDS  
 ALL INTERIOR WALLS ARE 3/2" (UNLESS NOTED)  
 EXHAUST BATH FANS ARE VENTED TO OUTSIDE AIR  
 \*3049 BATH (9.10 SQ.FT. OF CLEAR OPENING)  
 ALL BRICK LAYOUT MEASUREMENTS ARE 4"

PAGE NO: **3C**

ADDENDUM 1  
 VER: 092412  
 DRAWING BY: SES  
 SCALE: 1/8" = 1 FT.

TK  
 CONSTRUCTORS

DATE: October 19, 2012

JOB NO: 110-12-0031

TK CONSTRUCTORS  
 NEW ORLEANS

*Handwritten signature*