
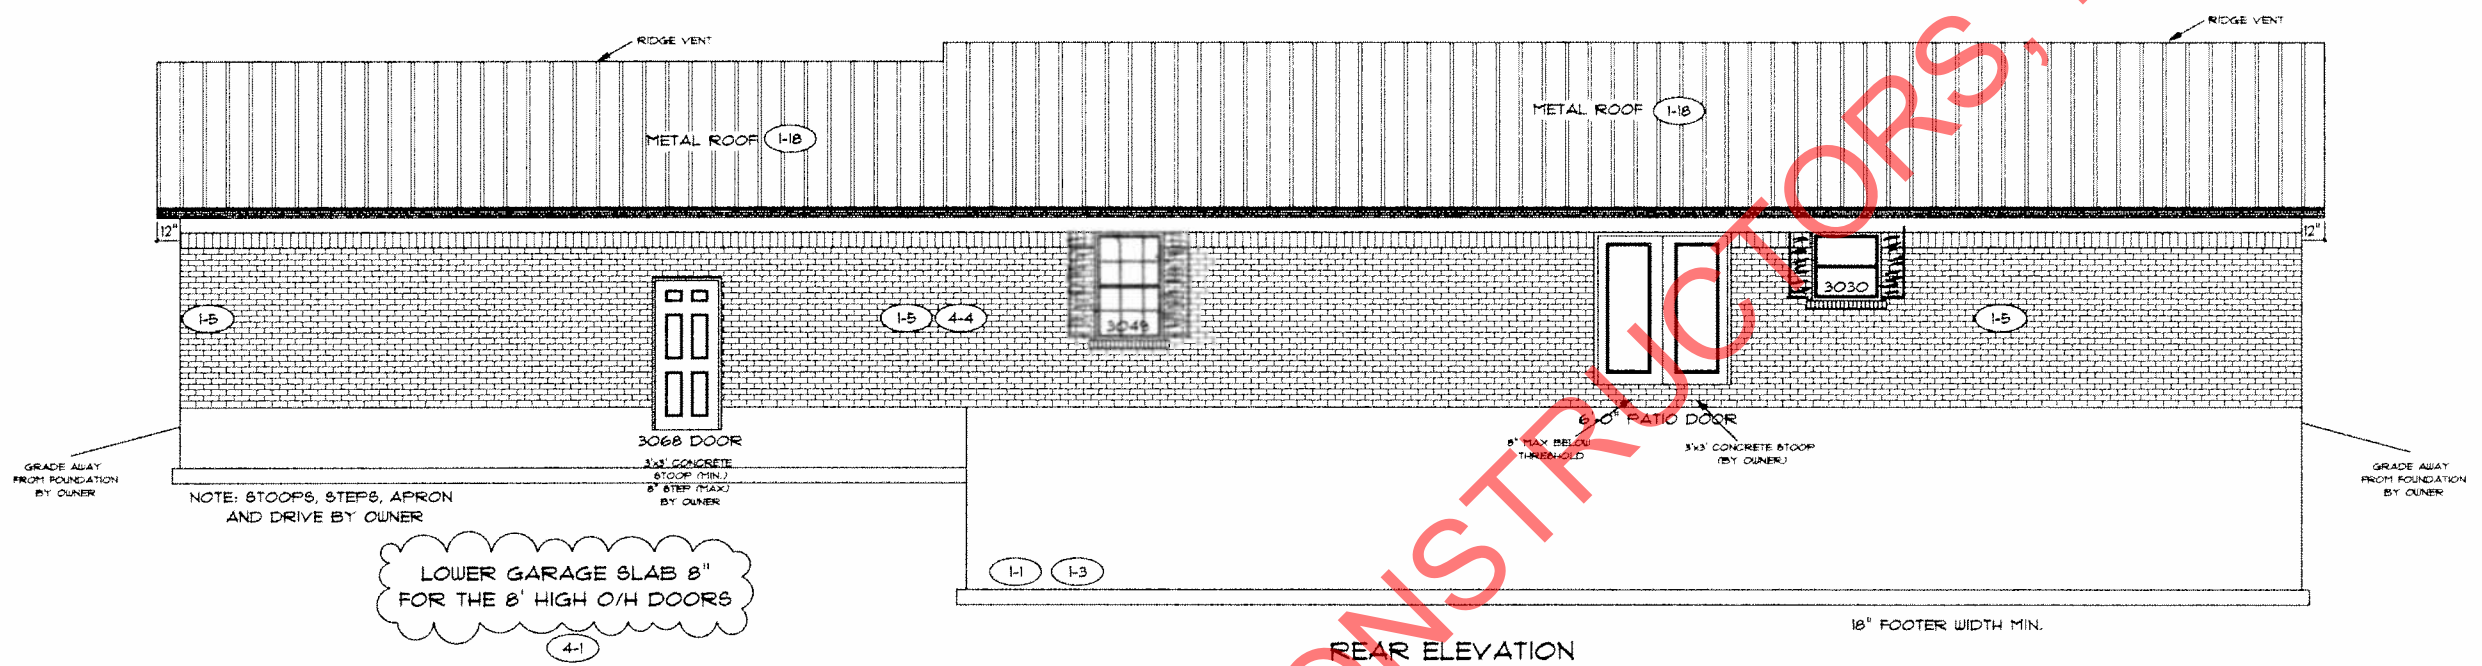


marked up F06
P.O's 5-3-16

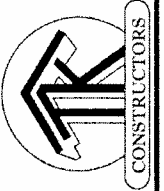

PROPERTY OF TK CONSTRUCTORS, INC

FLOOR PLAN

TOTAL LIVING SQ.FT.	1,763
GARAGE	959
TOTAL SQ.FT.	2,722
EXCLUDING PORCH	131

ANDERSEN WINDOW SCHEDULE - 200 SERIES -


ANDERSEN MODEL NO.	R.O. SIZE
3030	36" x 36"
3040	36" x 48"
3049*	36" x 57"
3056*	36" x 66"
3060*	36" x 72"
3049 MULL*	73" x 57"
3056 MULL*	73" x 66"
3060 MULL*	73" x 72"

ANDERSEN SLIDING DOOR	
R.O. 72 3/4" x 82 1/8"	
3'-0" FRONT DOOR	R.O. 38 3/8" x 82 1/2"
3'-0" FRONT DOOR WITH (1) SIDELITE	R.O. 51 7/8" x 82 1/2"
3'-0" FRONT DOOR WITH (2) SIDELITES	R.O. 65 3/8" x 82 1/2"
R.O. FOR BI-FOLD DOORS USING DRYWALL JAMB FACING + 1 1/4" + DOOR SIZE x (81 1/2")	
R.O. FOR BYPASS DOORS USING DRYWALL JAMB FACING MAKE SAME AS BOTH DOORS ADDED TOGETHER	
ALL INTERIOR DOORS SIZE + 2" TO WIDTH x 82 1/2" HIGH	
R.O. POCKET DOOR (2x DOOR WIDTH + 1") x 85" HIGH	

* - DENOTES OPENING MEETS EGRESS REQUIREMENTS

ALL WALL DIMENSIONS ARE FACE TO FACE OF STUDS
 ALL INTERIOR WALLS ARE 3/2" (UNLESS NOTED)
 EXHAUST BATH FANS ARE VENTED TO OUTSIDE AIR
 *3049 BASH (B.T.O SQ.FT. OF CLEAR OPENING)
 ALL BRICK LAYOUT MEASUREMENTS ARE 4"

2x6 EXTERIOR HOUSE WALLS:
 2x4 GARAGE WALLS

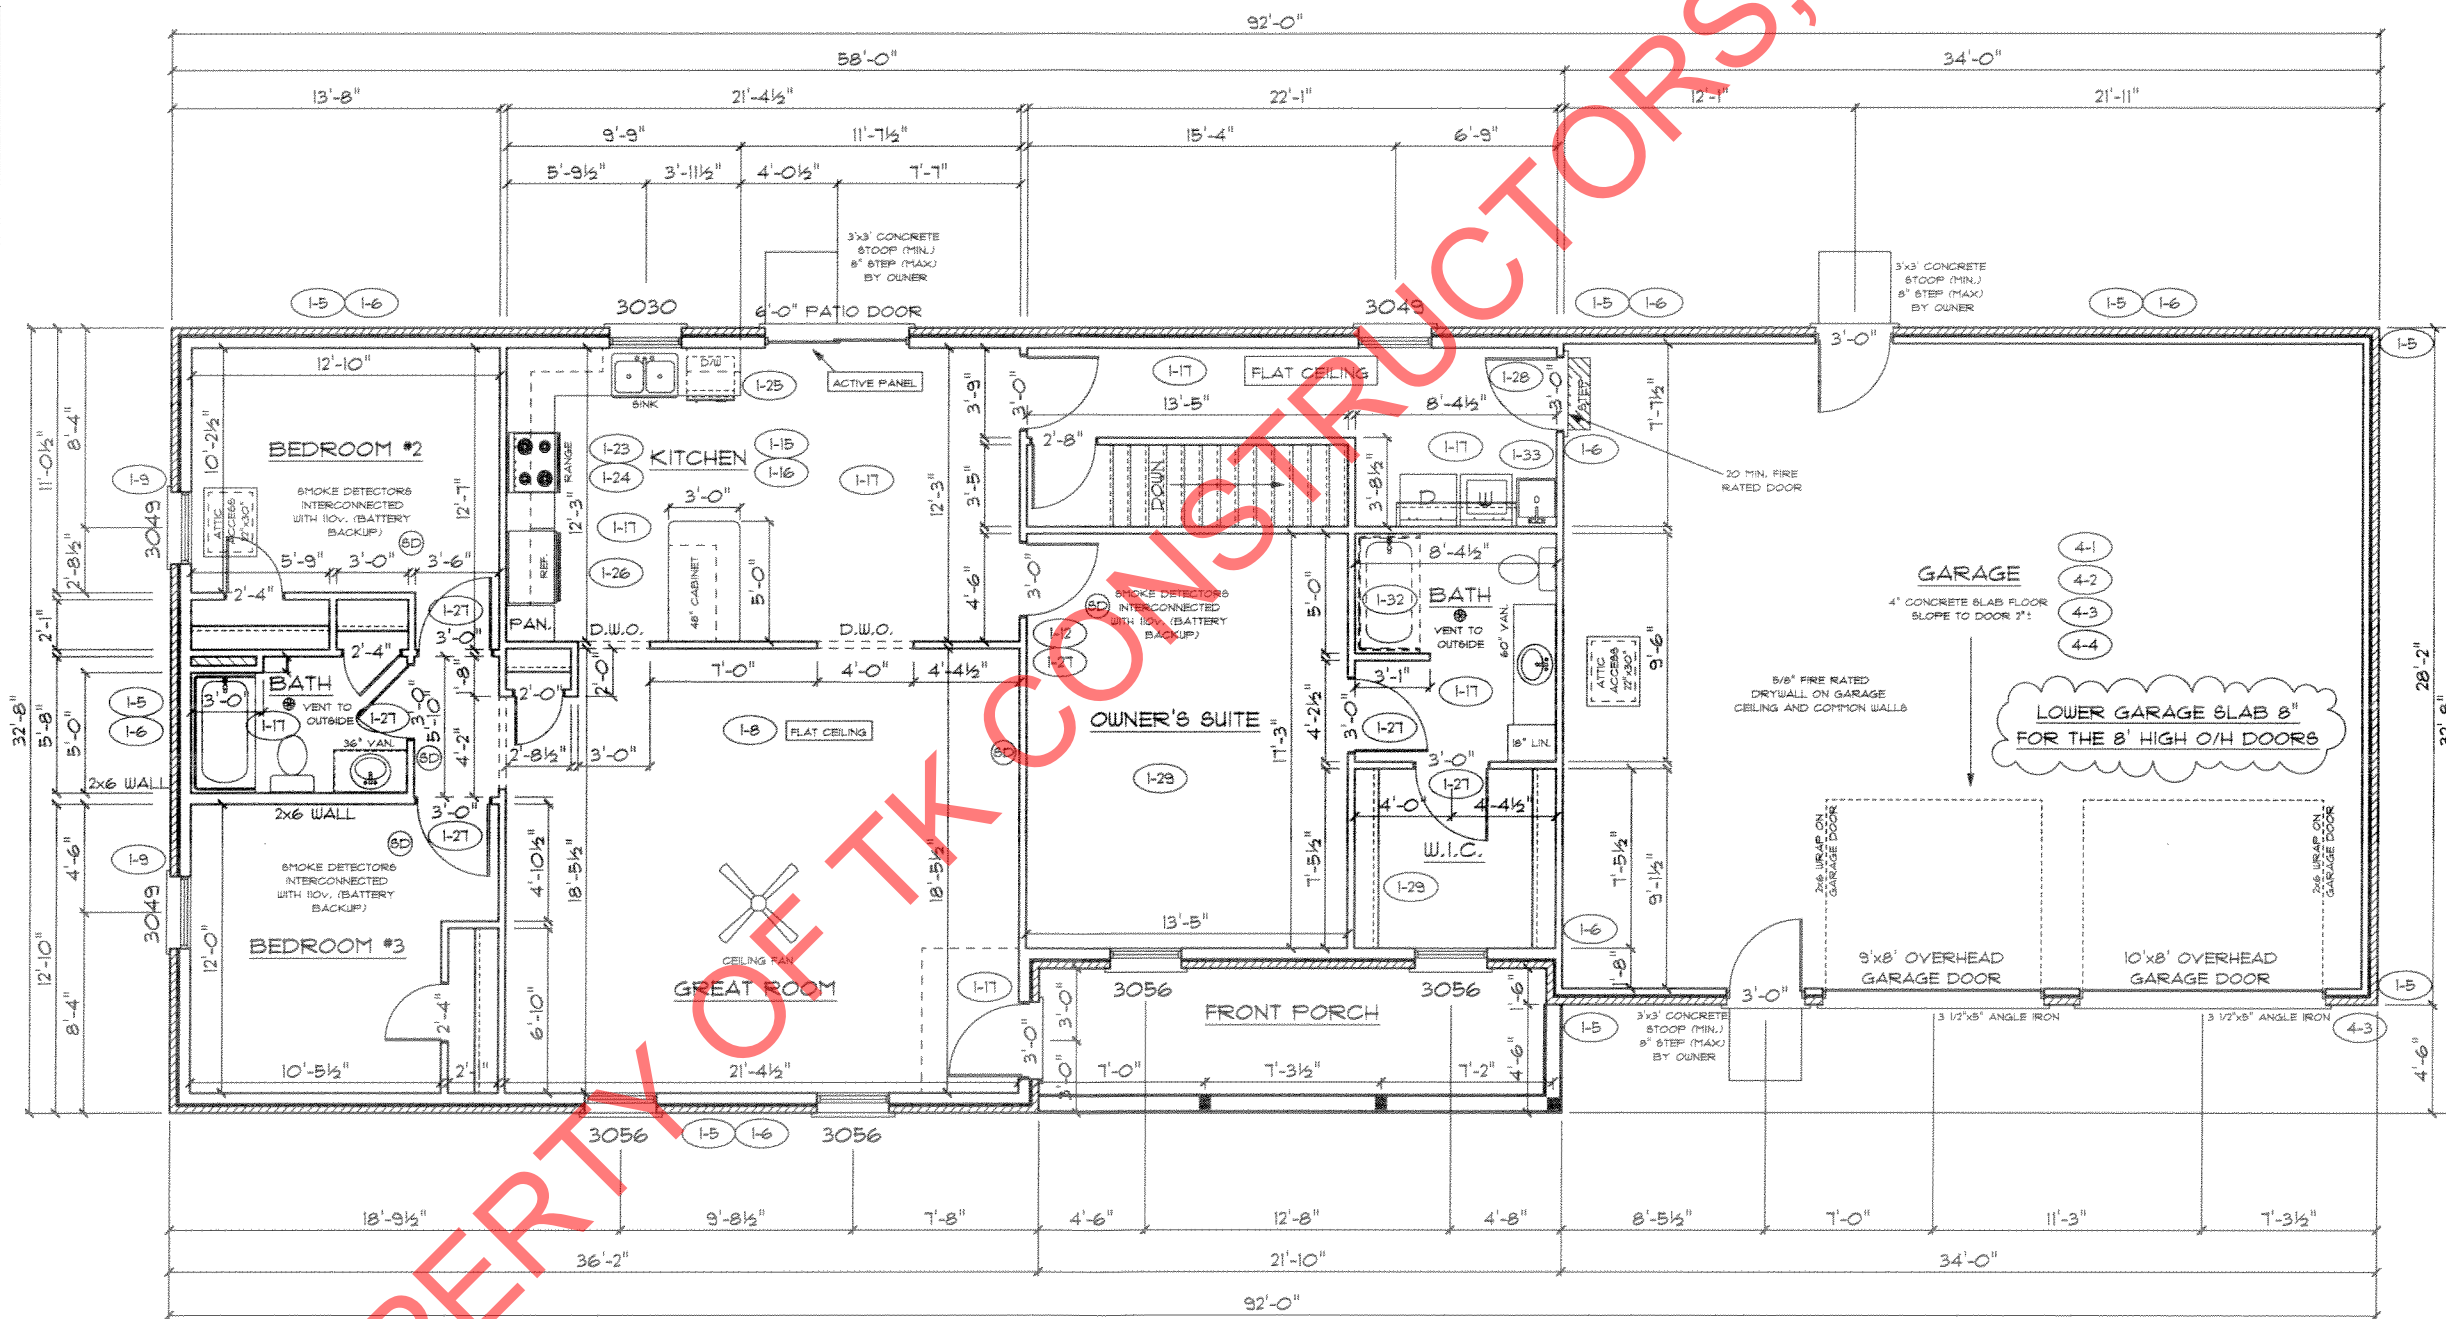

PAGE NO: **3B**
 ADDENDUM 1, 4
 VER: 08:18 AM
 DRAWING BY: GW, NL
 1/8" = 1'
 DATE: April 26, 2016
 JOB NO: 210-16-0129
TK CONSTRUCTORS
 RALEIGH