



marked up. 6-10-15

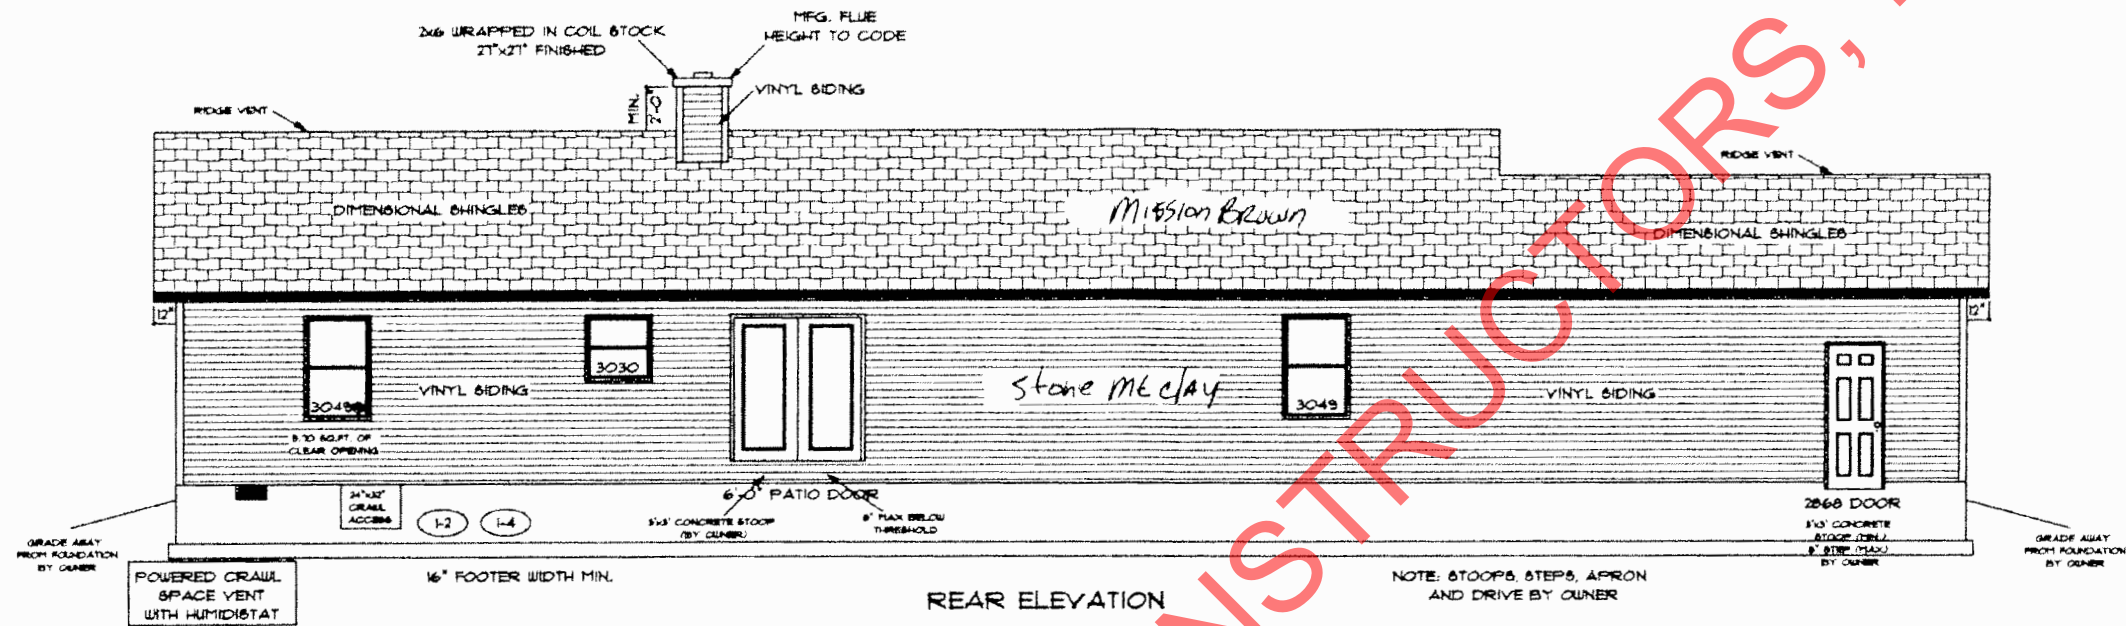

REAR ELEVATION

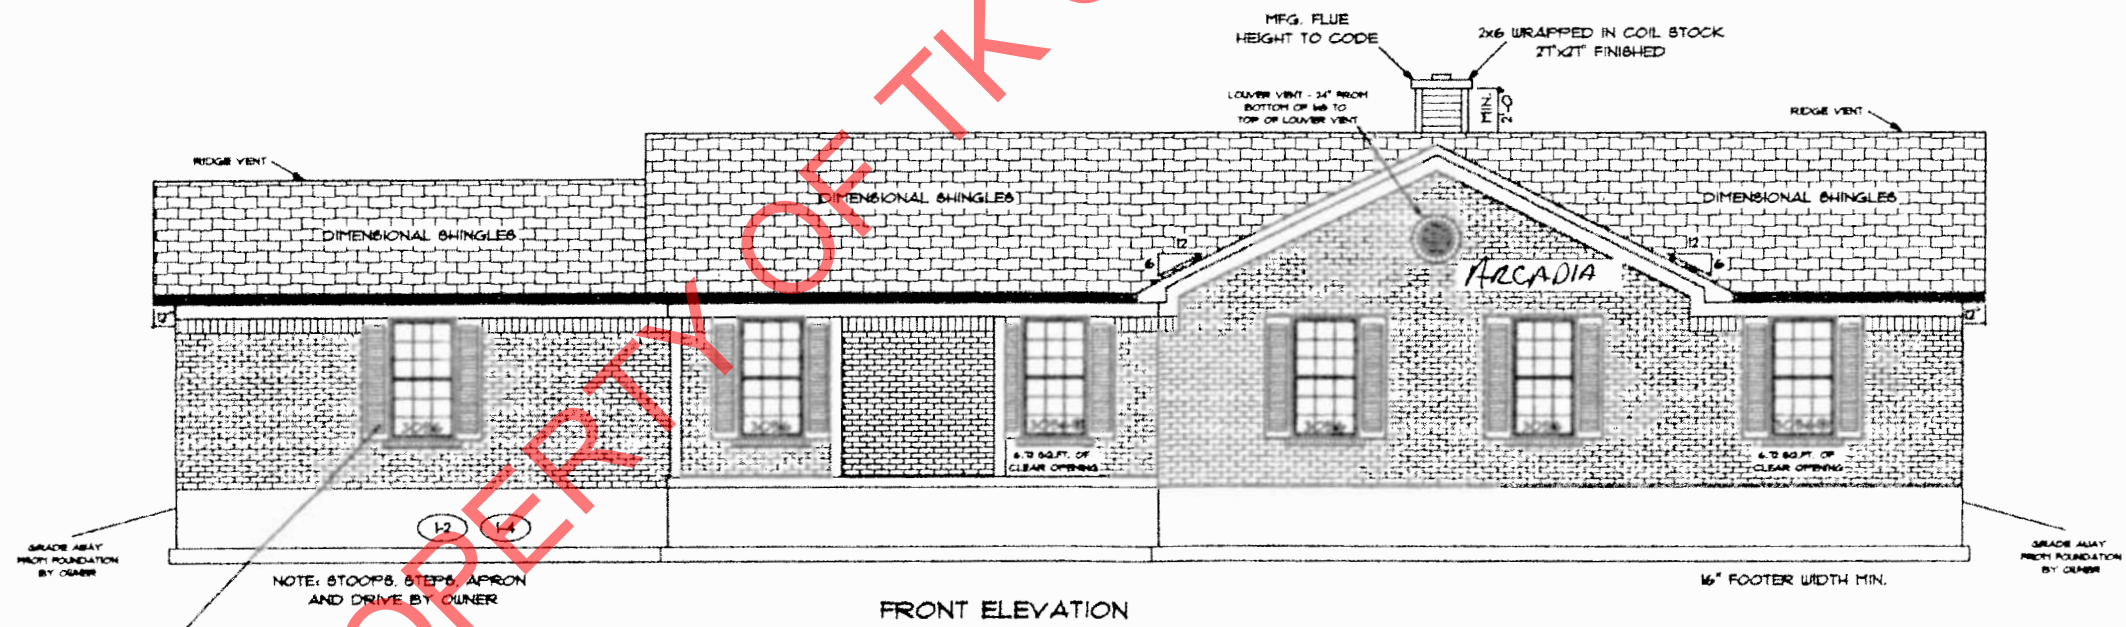

FRONT ELEVATION

Lowered 04 Wedgewood Blue

PAGE NO.: 10

ADDENDUM 1

12:18 PM

DRAWING BY: GW

1/8" = 1'

DATE: April 21, 2015

JOB NO.: 214-15-0131

TK CONSTRUCTORS

RALEIGH

OK BF

Cabinets
Glenwood Beach

Microwave
Refrigerator

Pure White
Paint

Corona Knobs
Aged Bronze
+ Dead Bolts

FLOOR PLAN

TOTAL LIVING SQ.FT.	1,763
GARAGE	499
TOTAL SQ.FT.	2,262
EXCLUDING PORCH	132


ANDERSEN WINDOW SCHEDULE
- 200 SERIES -

ANDERSEN MODEL NO.	R.O. SIZE
3030	36" x 36"
3040	36" x 48"
3049	36" x 51"
3056	36" x 66"
3060	36" x 72"
3049 MULL.	73" x 57"
3056 MULL.	73" x 66"
3060 MULL.	73" x 72"

ANDERSEN SLIDING DOOR R.O. 72 3/4" x 82 1/8"
3'-0" FRONT DOOR R.O. 38 3/8" x 82 1/2"
3'-0" FRONT DOOR WITH (1) SIDELITE R.O. 51 7/8" x 82 1/2"
3'-0" FRONT DOOR WITH (2) SIDELITES R.O. 65 3/8" x 82 1/2"
R.O. FOR BI-FOLD DOORS USING DRYWALL JAMB FACING = 1 1/4" + DOOR SIZE x (81 1/2")
R.O. FOR BYPASS DOORS USING DRYWALL JAMB FACING MAKE SAME AS BOTH DOORS ADDED TOGETHER
ALL INTERIOR DOORS SIZE = 2" TO WIDTH x 82 1/2" HIGH
R.O. POCKET DOOR (2x DOOR WIDTH + 1") x 85" HIGH

** DENOTES OPENING MEETS
EGRESS REQUIREMENTS

ALL WALL DIMENSIONS ARE FACE TO FACE OF STUDS
ALL INTERIOR WALLS ARE 3 1/2" (UNLESS NOTED)
EXHAUST BATH FANS ARE VENTED TO OUTSIDE AIR
3049 BATH (8,70 SQ.FT. OF CLEAR OPENING)
ALL BRICK LAYOUT MEASUREMENTS ARE 4"

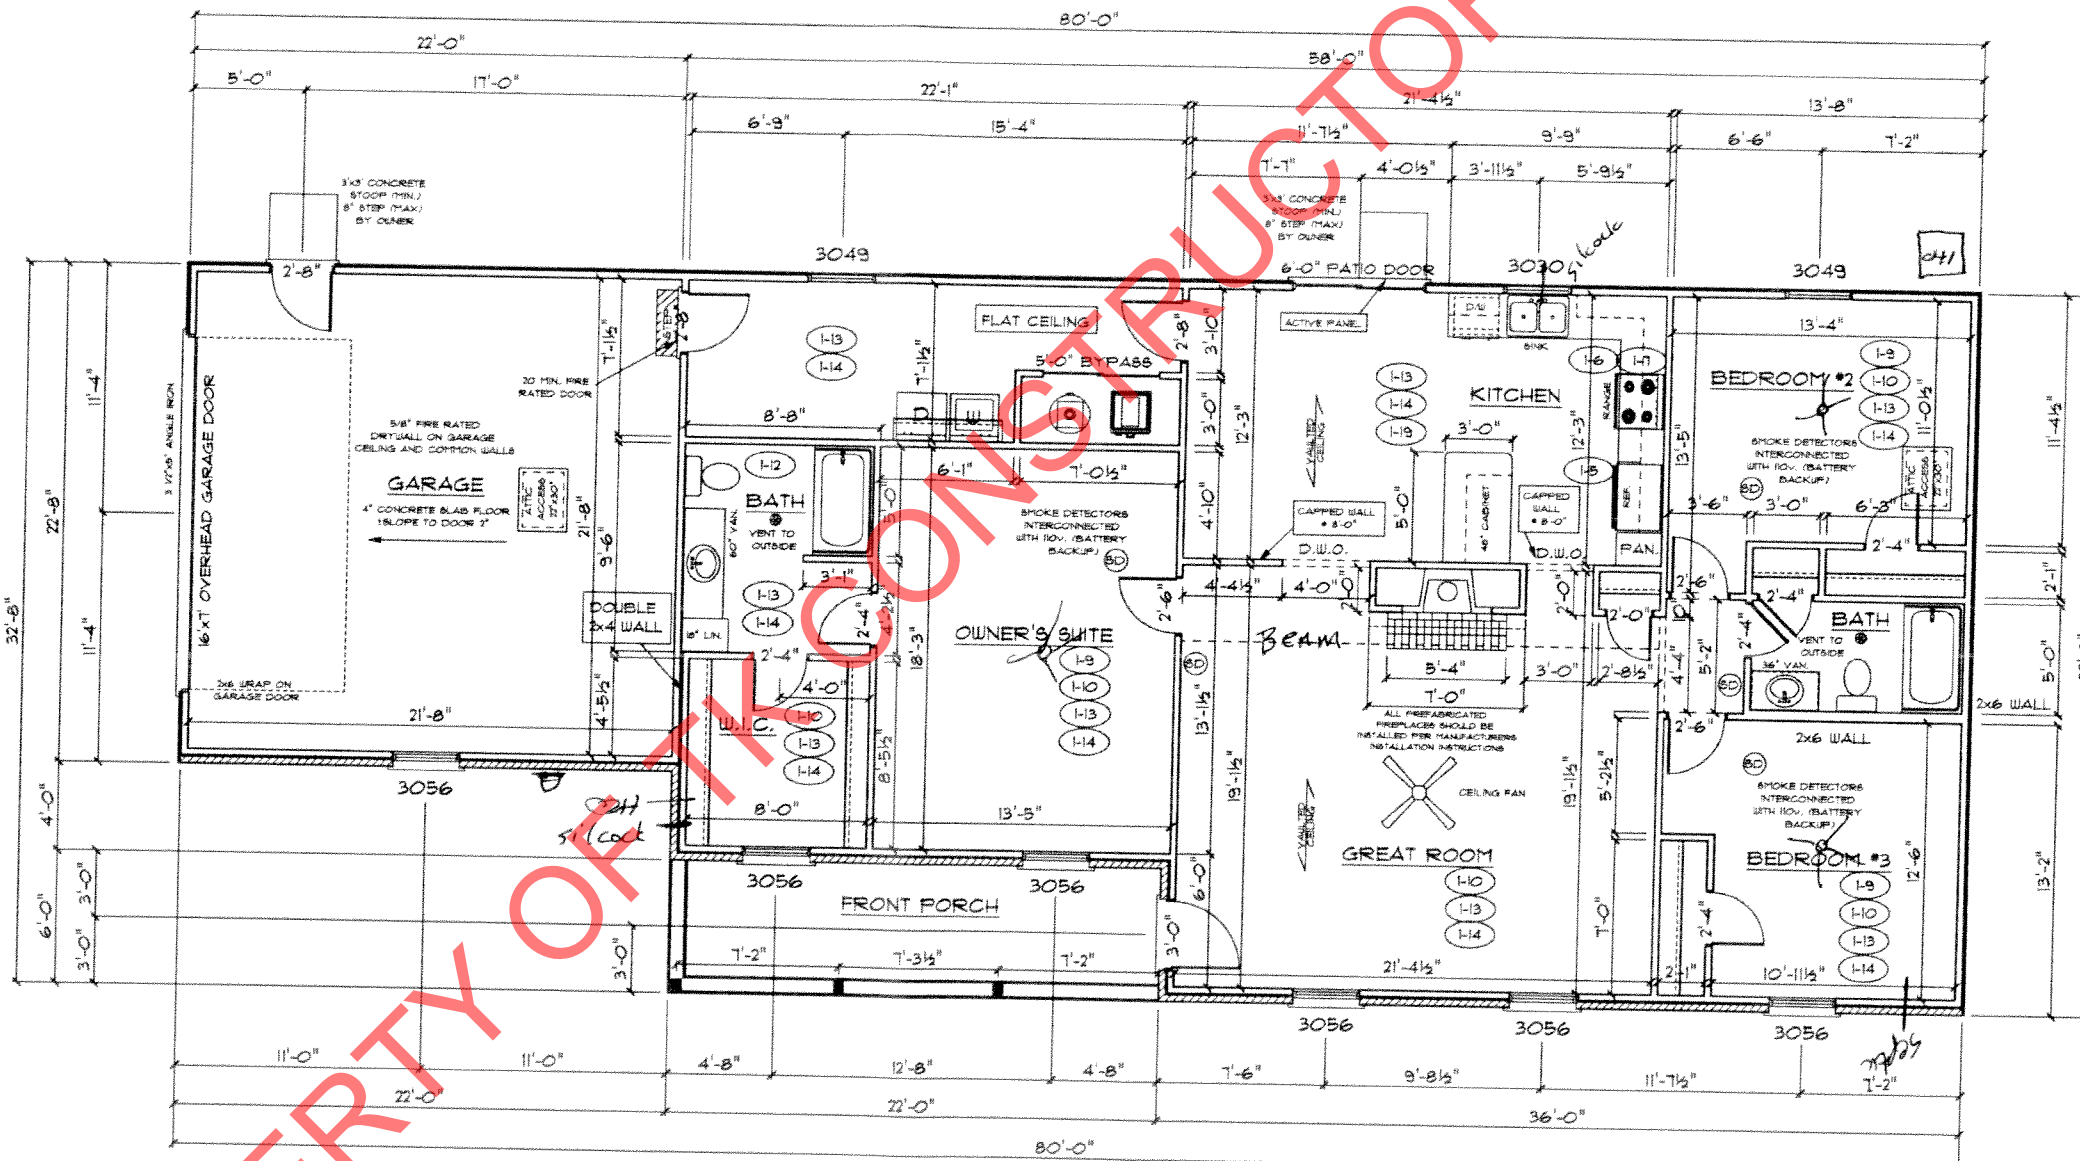

PROPERTY OF
TK CONSTRUCTORS, INC

PAGE NO:


30

APPENDUM 1

12:19 PM

DRAWING BY: GW

1/8" = 1'

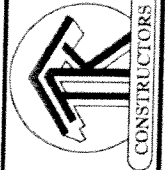

CONSTRUCTORS

DATE: April 21, 2015

JOB NO: 214-15-0131

TK CONSTRUCTORS

RALEIGH

DF PF