


CAD EDIT

- *WINDOW IN THE DINING ROOM AND IN BEDROOM #4 MOVED 6".
- *REARRANGED PORCH POSTS AND RAILING
- *BRICK ON SIDE OF WRAP AROUND PORCH TO BE TAKEN OFF.

FRONT ELEVATION


SCALE: 1/8 IN = 1 FT

Property of THE CONSTRUCTORS, INC

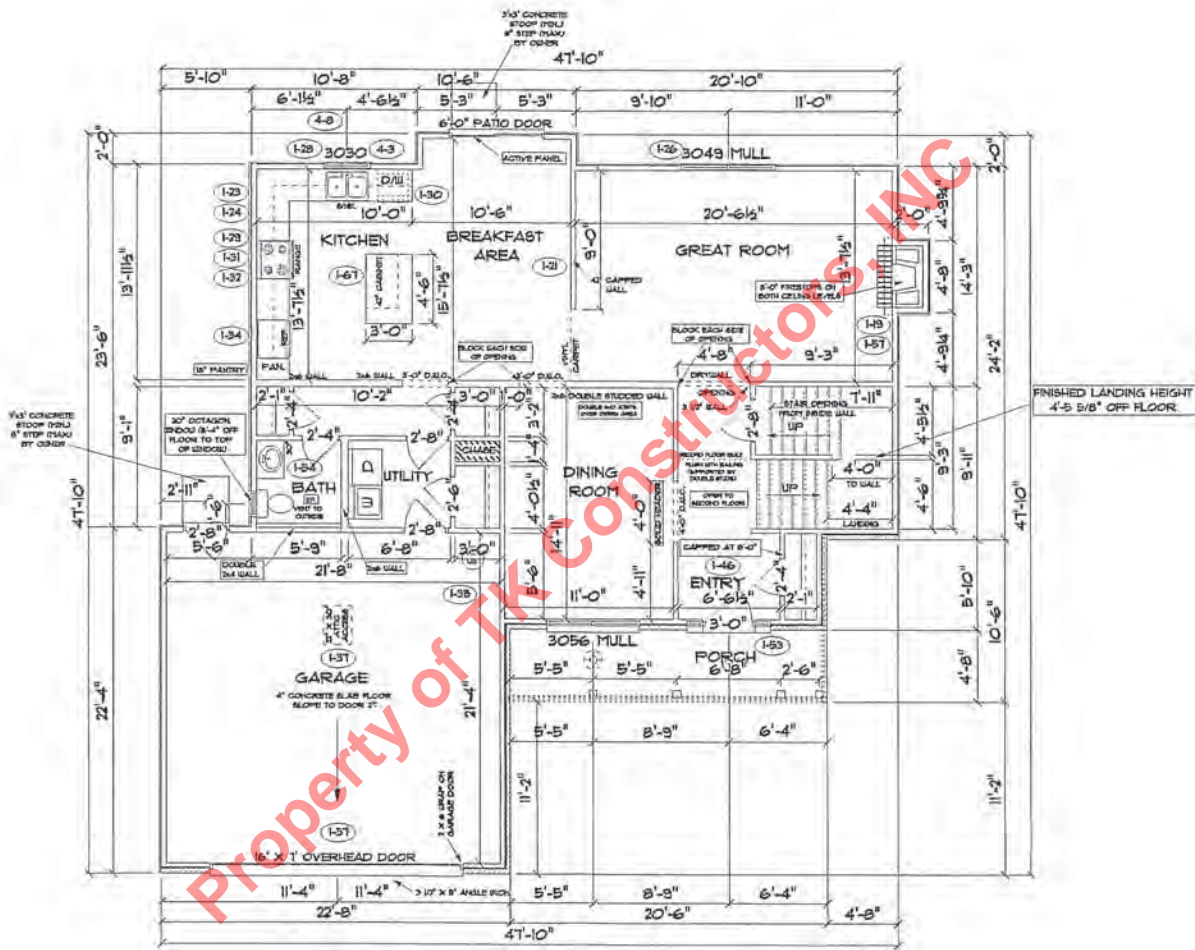

FIRST FLOOR PLAN

SCALE: 1/8 IN = 1 FT

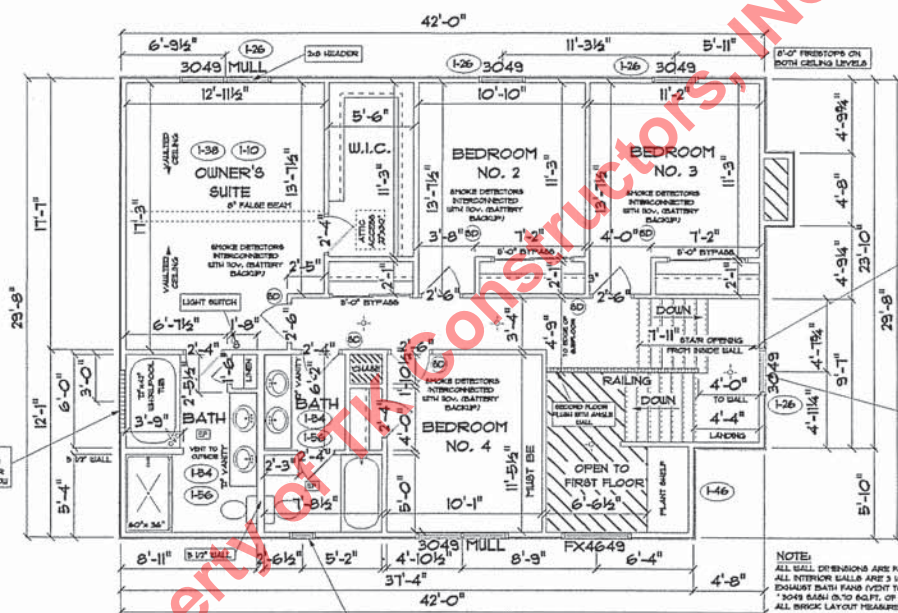

MODEL	R.O. SIZE
3030	36" x 36"
3043	36" x 51"
3056	36" x 66"
3049 MULL	73" x 51"
3056 MULL	73" x 66"

ANDERSEN SLIDING DOOR	R.O. T2 3/4" x 82 7/8"
3/0 FRONT DOOR	R.O. 3'-2 1/2" x 82 1/2"
3/0 FRONT DOOR WITH (U) SIDE LIGHT	R.O. 4'-3 1/2" x 82"
3/0 FRONT DOOR WITH (J) SIDE LIGHTS	R.O. 5'-5" x 82"
R.O. FOR BYFOLD DOORS USING DRY-WALL JAMB FACING IS 1 1/4" DOOR SIZE	
R.O. FOR BYPASS DOORS USING DRY-WALL JAMB FACING MAKE SAME AS BOTH DOORS ADDED TOGETHER	
ALL INTERIOR DOORS	SIZE + 2" TO WIDTH x 82 1/2" HIGH

SECOND FLOOR PLAN

FIRST FLOOR	1166 SQ. FT.
SECOND FLOOR	1068 SQ. FT.
TOTAL LIVING SPACE	2234 SQ. FT.
GARAGE	506 SQ. FT.
TOTAL SQ. FT.	2,740 SQ. FT.
(EXCLUDING FRONT PORCH)	96 SQ. FT.

SCALE: 1/8 IN. = 1 FT.